



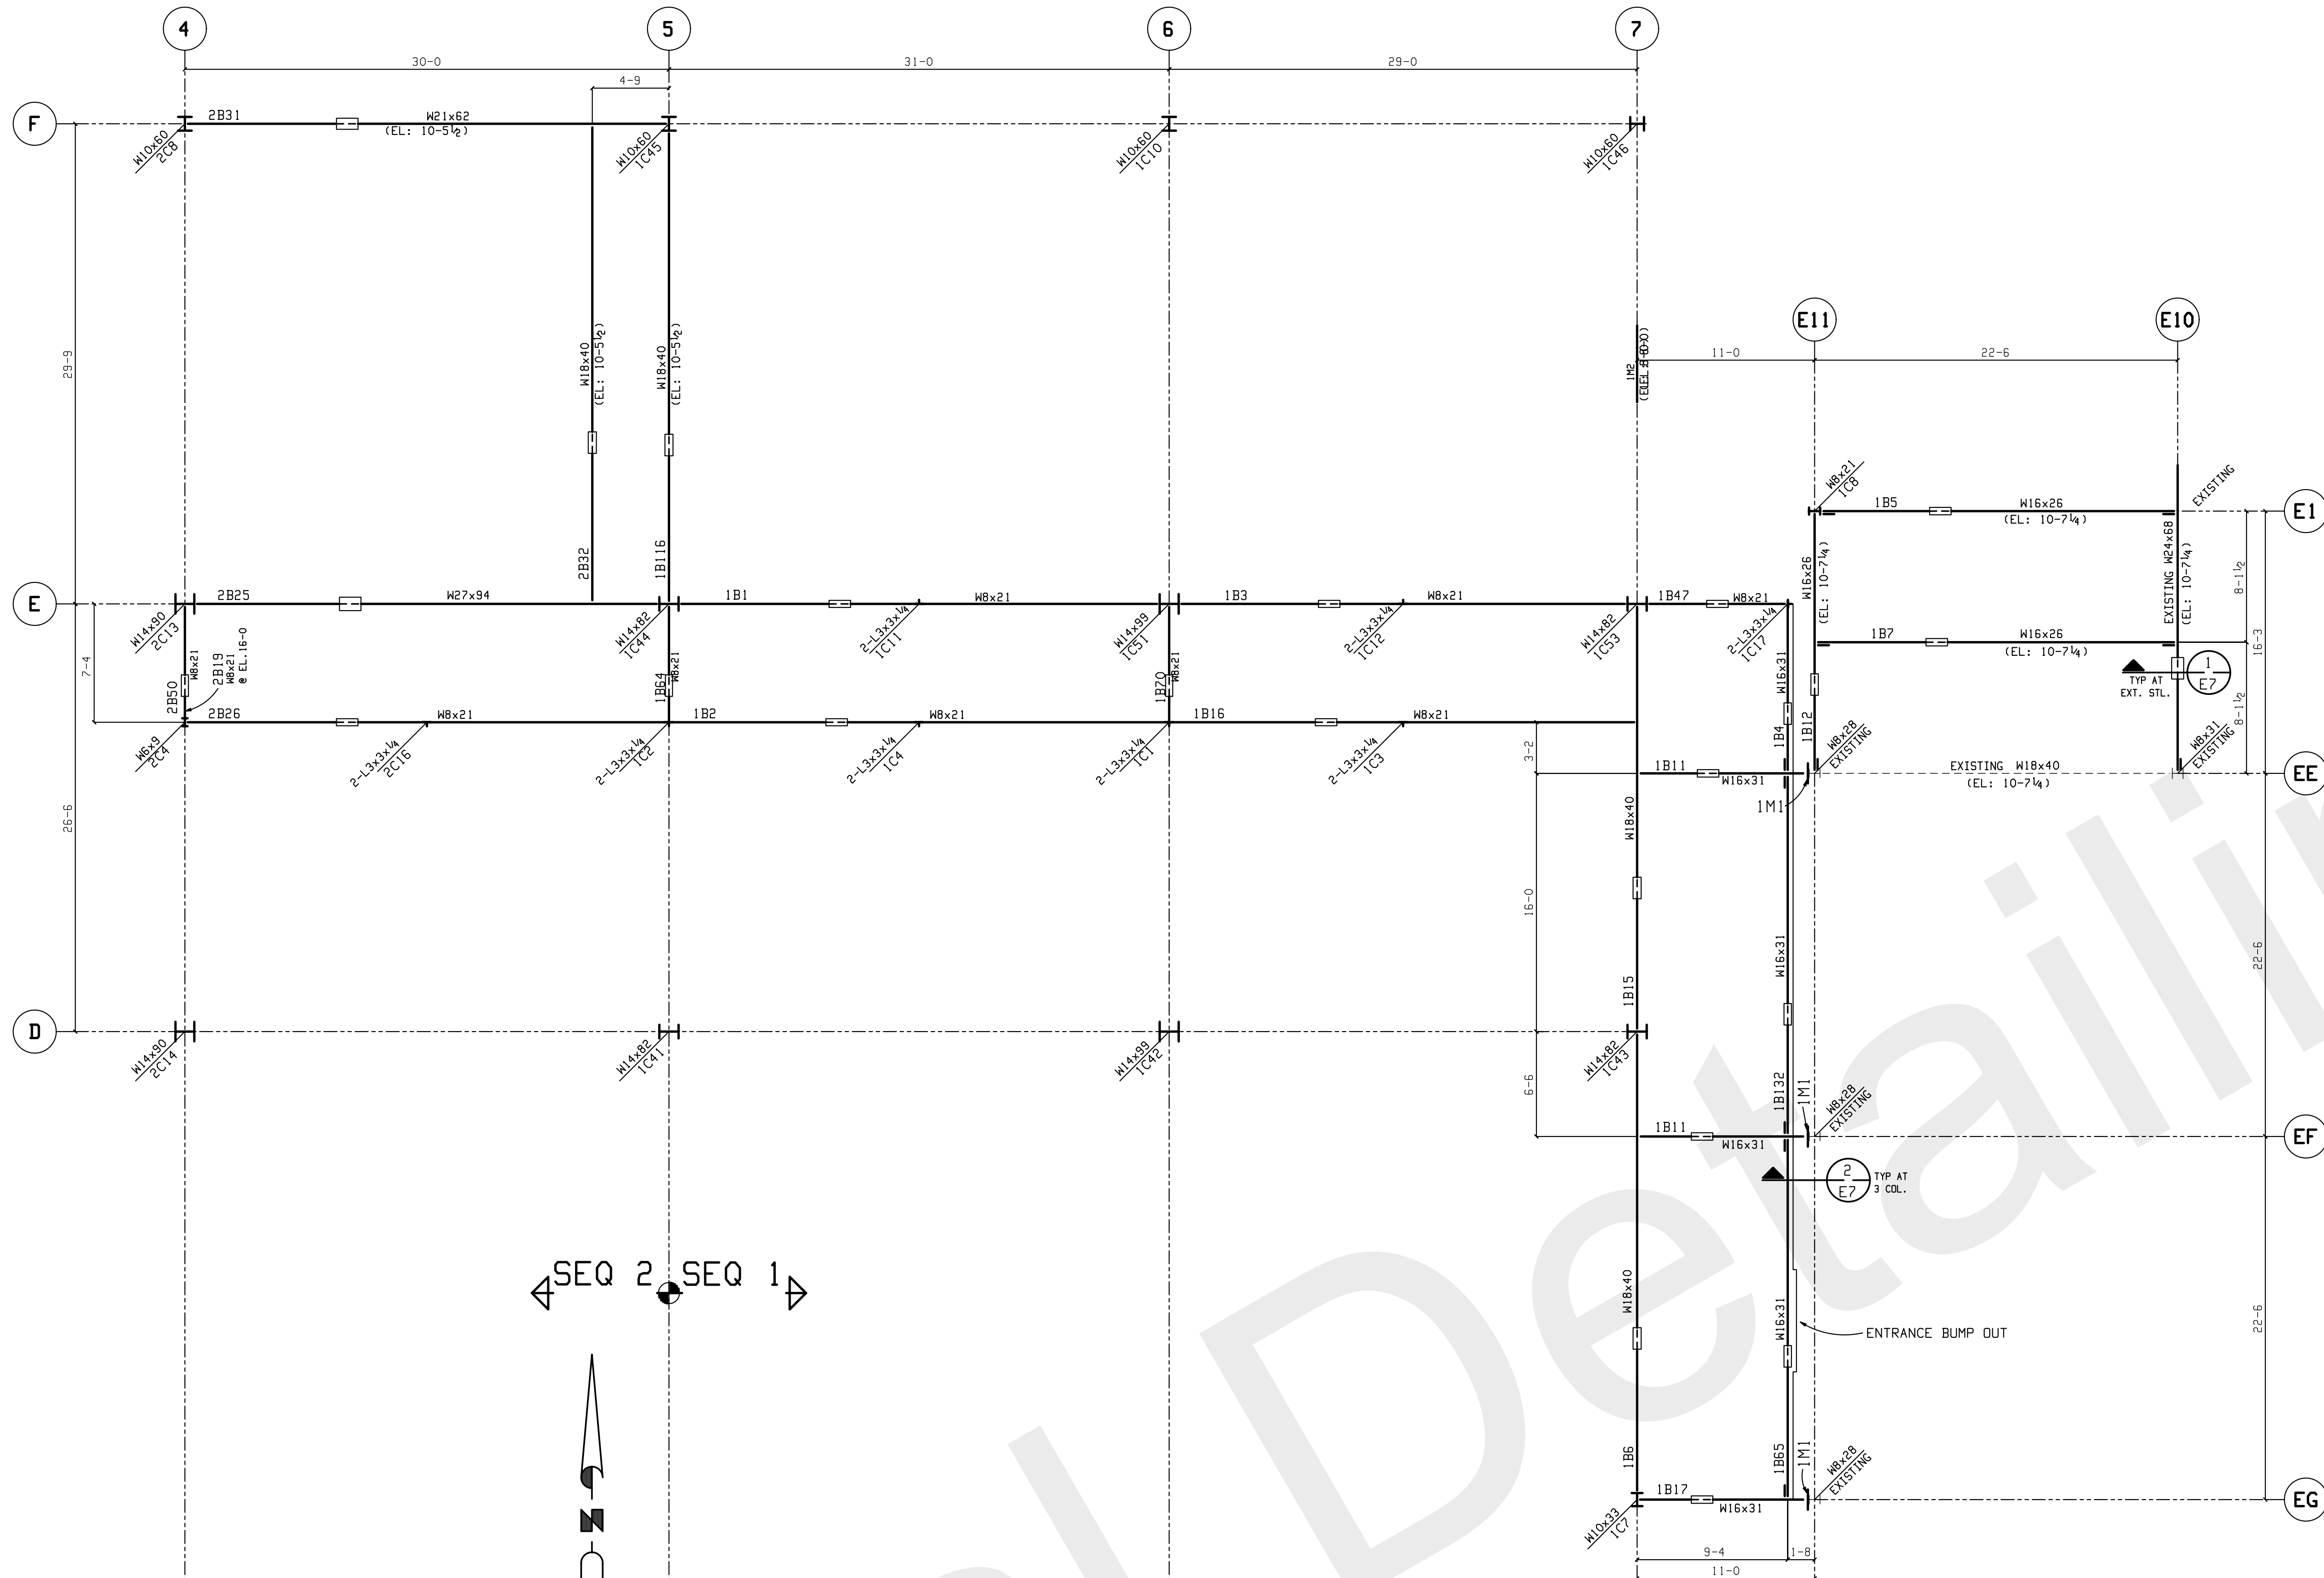

SEQ 2 SEQ 1

WALKWAY FRAMING PLAN

1) T.O. STEEL AT ELEVATION: 10-5½ U.N.

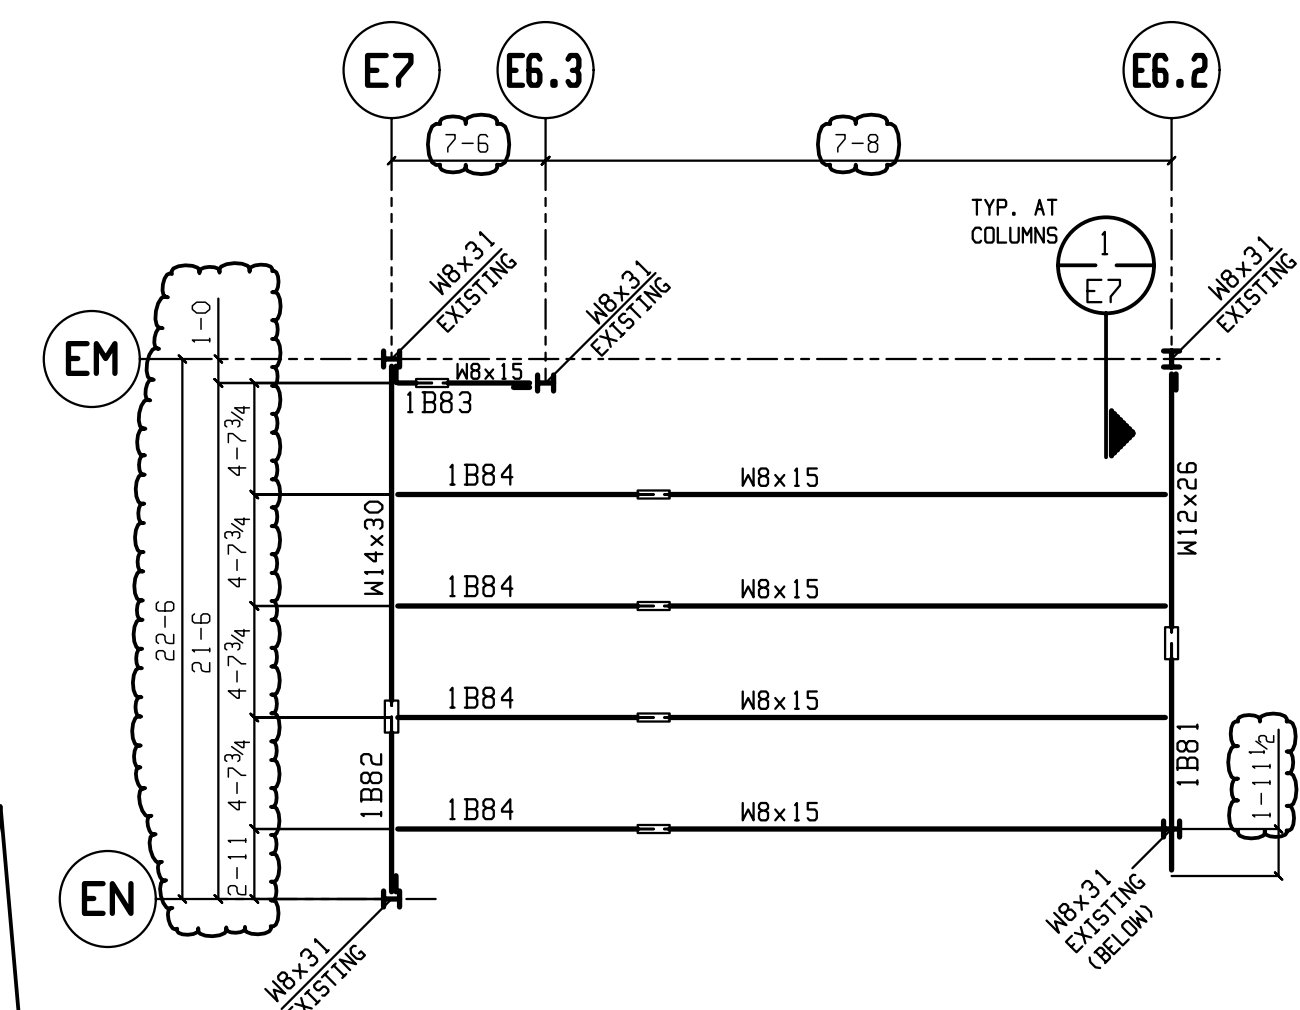

EXISTING RESTAURANT ROOF

- 1) T.O. STEEL ELEVATION: 15-7
- 2) MATERIAL IS IN SEQUENCE 1

NOTE: AREA "ON HOLD"
PENDING ARCHITECT DETAILS
PER APPROVAL MARK UPS
DATED JAN.9, 2012

ALL VERIFIES, REQUEST FOR INFORMATION NOT
RESPONDED TO AND/OR DIMENSIONS NOT FURNISHED
WILL PLACE AFFECTED STEEL ON HOLD.

JEFFORDS STEEL AND ENGINEERING ASSUMES NO
RESPONSIBILITY FOR ERRORS RESULTING FROM
CONFLICTS IN CONTRACT DRAWINGS (ARCHITECTURAL/
STRUCTURAL).

GENERAL NOTES:

CHARGES FOR CORRECTIVE WORK WILL NOT BE HONORED UNLESS
PREVIOUS APPROVAL IS OBTAINED FROM JEFFORDS STEEL AND
ENGINEERING COMPANY.

MEMBERS ARE TO BE ERECTED SO THAT MARKED END IS IN THE
SAME LOCATION AS ON THE ERECTION DRAWING.

print record			
1	APP	12-4	
1	APP	1-6	
1	APP	2-16	

job no. 487	date 1-12	drawn by MC	checked by - GHT
-------------	-----------	-------------	------------------


revisions		description	
rev#	date		

JEFFORDS
STEEL AND ENGINEERING COMPANY
P.O. BOX 488 ROUTE 422
PLATTSBURGH, NY 12001
518-561-4061

CUSTOMER
ENCOMPASS DEVELOP
DESIGN CONSTRUCTION

PROJECT
AKWESASNE MOHAWK CASINO
873 STATE HIGHWAY 37
AKWESASNE, NY

SHEET
E1

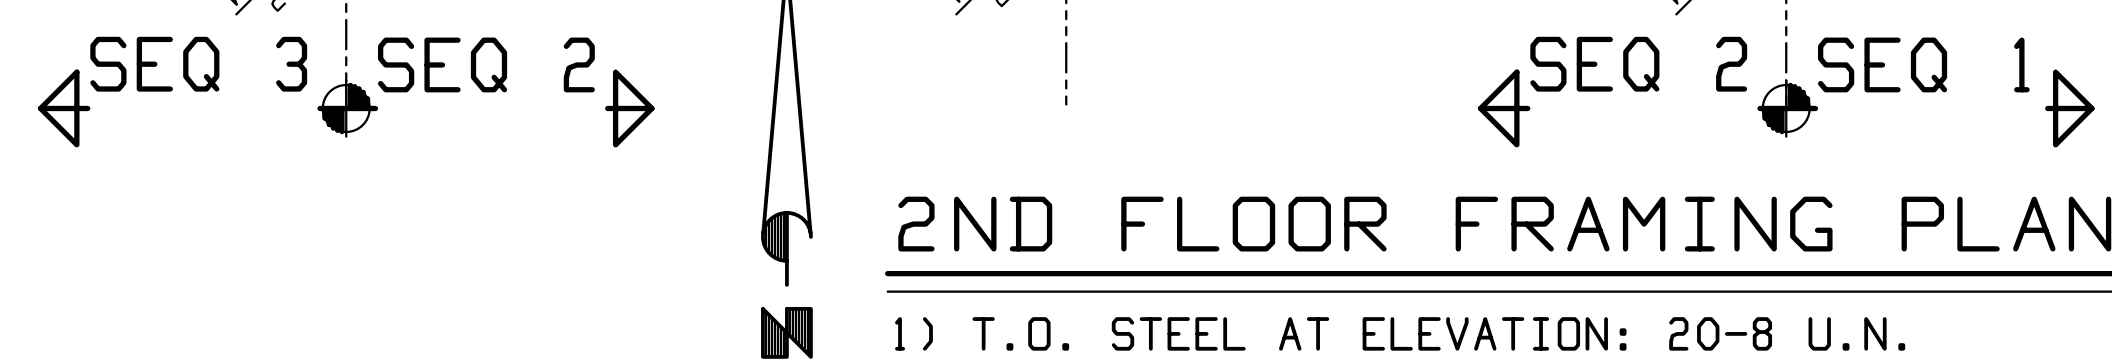

ERECTION NORTH

print record		
1	APP	1-5
1	APP	1-6
1	FIELD (NO FILE ONLY)	2-16

job no. 4457
date 1-4-12
drawn by MC
checked by - GDI

revisions		
rev#	date	description
1	3-5-12	ADDED ROOF FRAMES
2	3-19-12	FIX MECH FRAMES
3	3-22-12	ADDED L3x3x3/8x2ND FLR MEZZ ALONG COL. LN. D

Jeffords
STEEL AND ENGINEERING COMPANY
P.O. BOX 40-4398 ROUTE #22
PLATTSBURGH, N.Y. 12901
518-561-4061

ENCOMPASS DEVELOP
DESIGN CONSTRUCTION

customer

AKWESASNE MOHAWK CASINO
873 STATE HIGHWAY 37
AKWESASNE, NY

sheet

E2



ALL VERIFIES, REQUEST FOR INFORMATION NOT
RESPONDED TO AND/OR DIMENSIONS NOT FURNISHED
WILL PLACE AFFECTED STEEL ON HOLD.

JEFFORDS STEEL AND ENGINEERING ASSUMES NO
RESPONSIBILITY FOR ERRORS RESULTING FROM
CONFLICTS IN CONTRACT DRAWINGS (ARCHITECTURAL
STRUCTURAL).

GENERAL NOTES:

CHARGES FOR CORRECTIVE WORK WILL NOT BE HONORED UNLESS PREVIOUS APPROVAL IS OBTAINED FROM JEFFORDS STEEL AND ENGINEERING COMPANY.

MEMBERS ARE TO BE ERECTED SO THAT MARKED END IS IN THE SAME LOCATION AS ON THE ERECTION DRAWING.

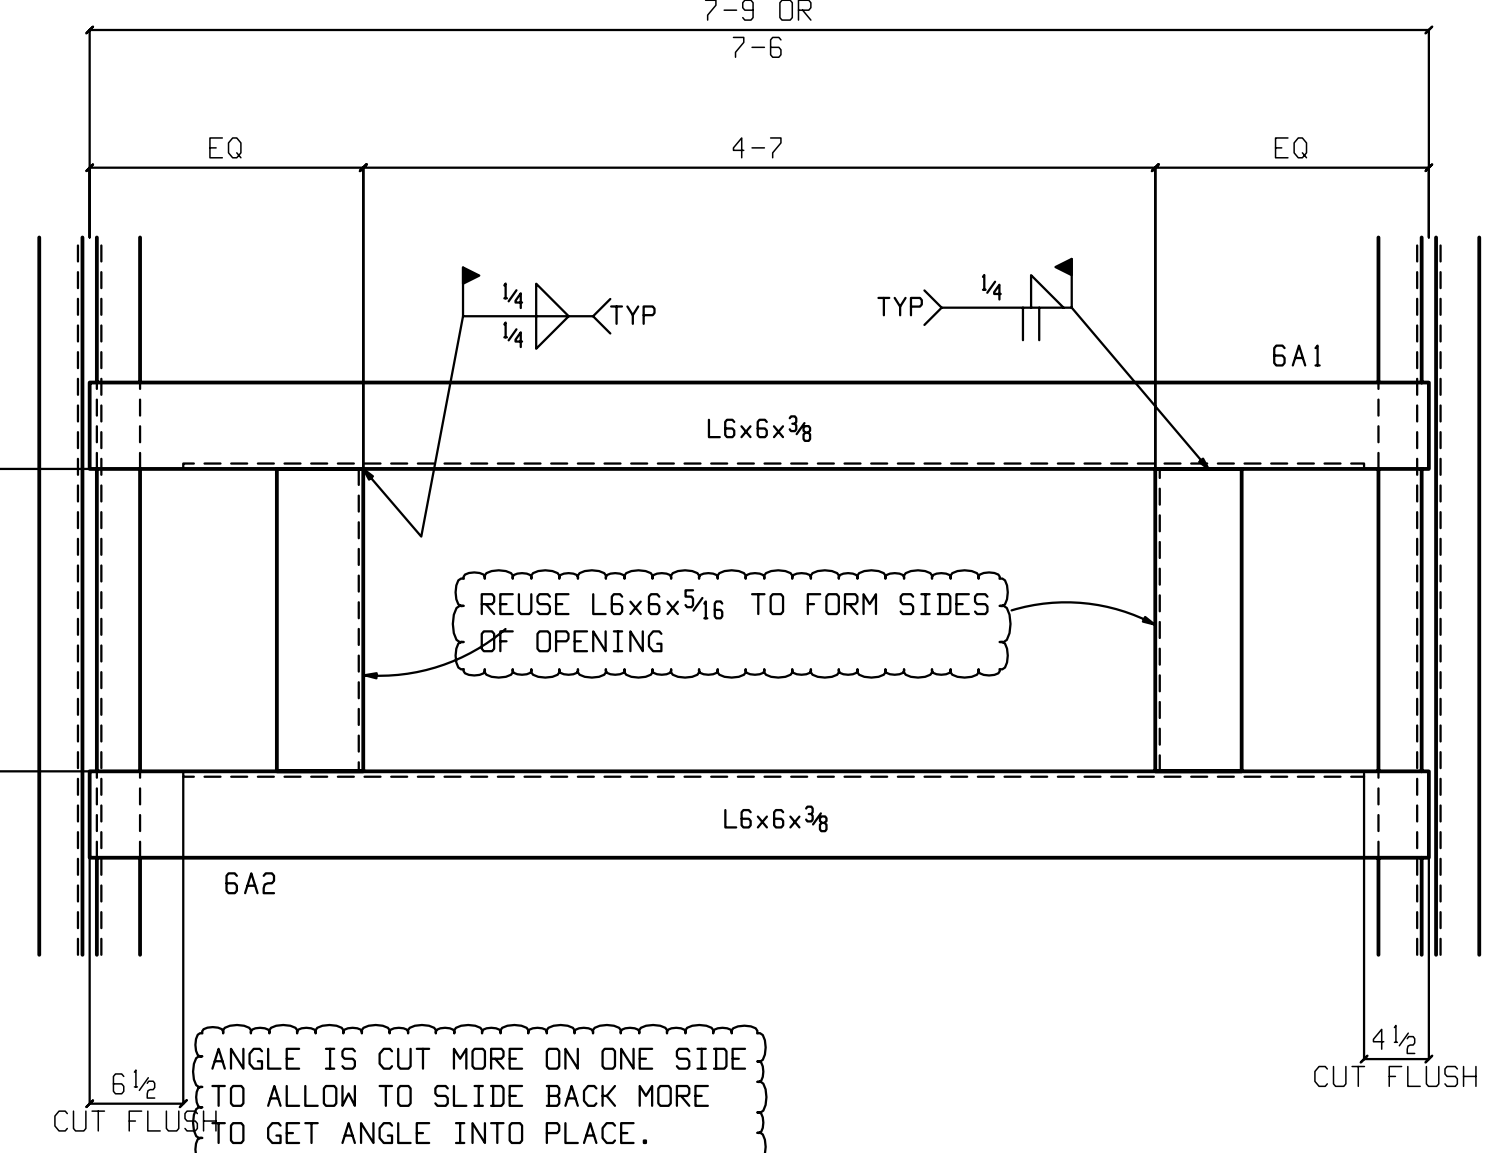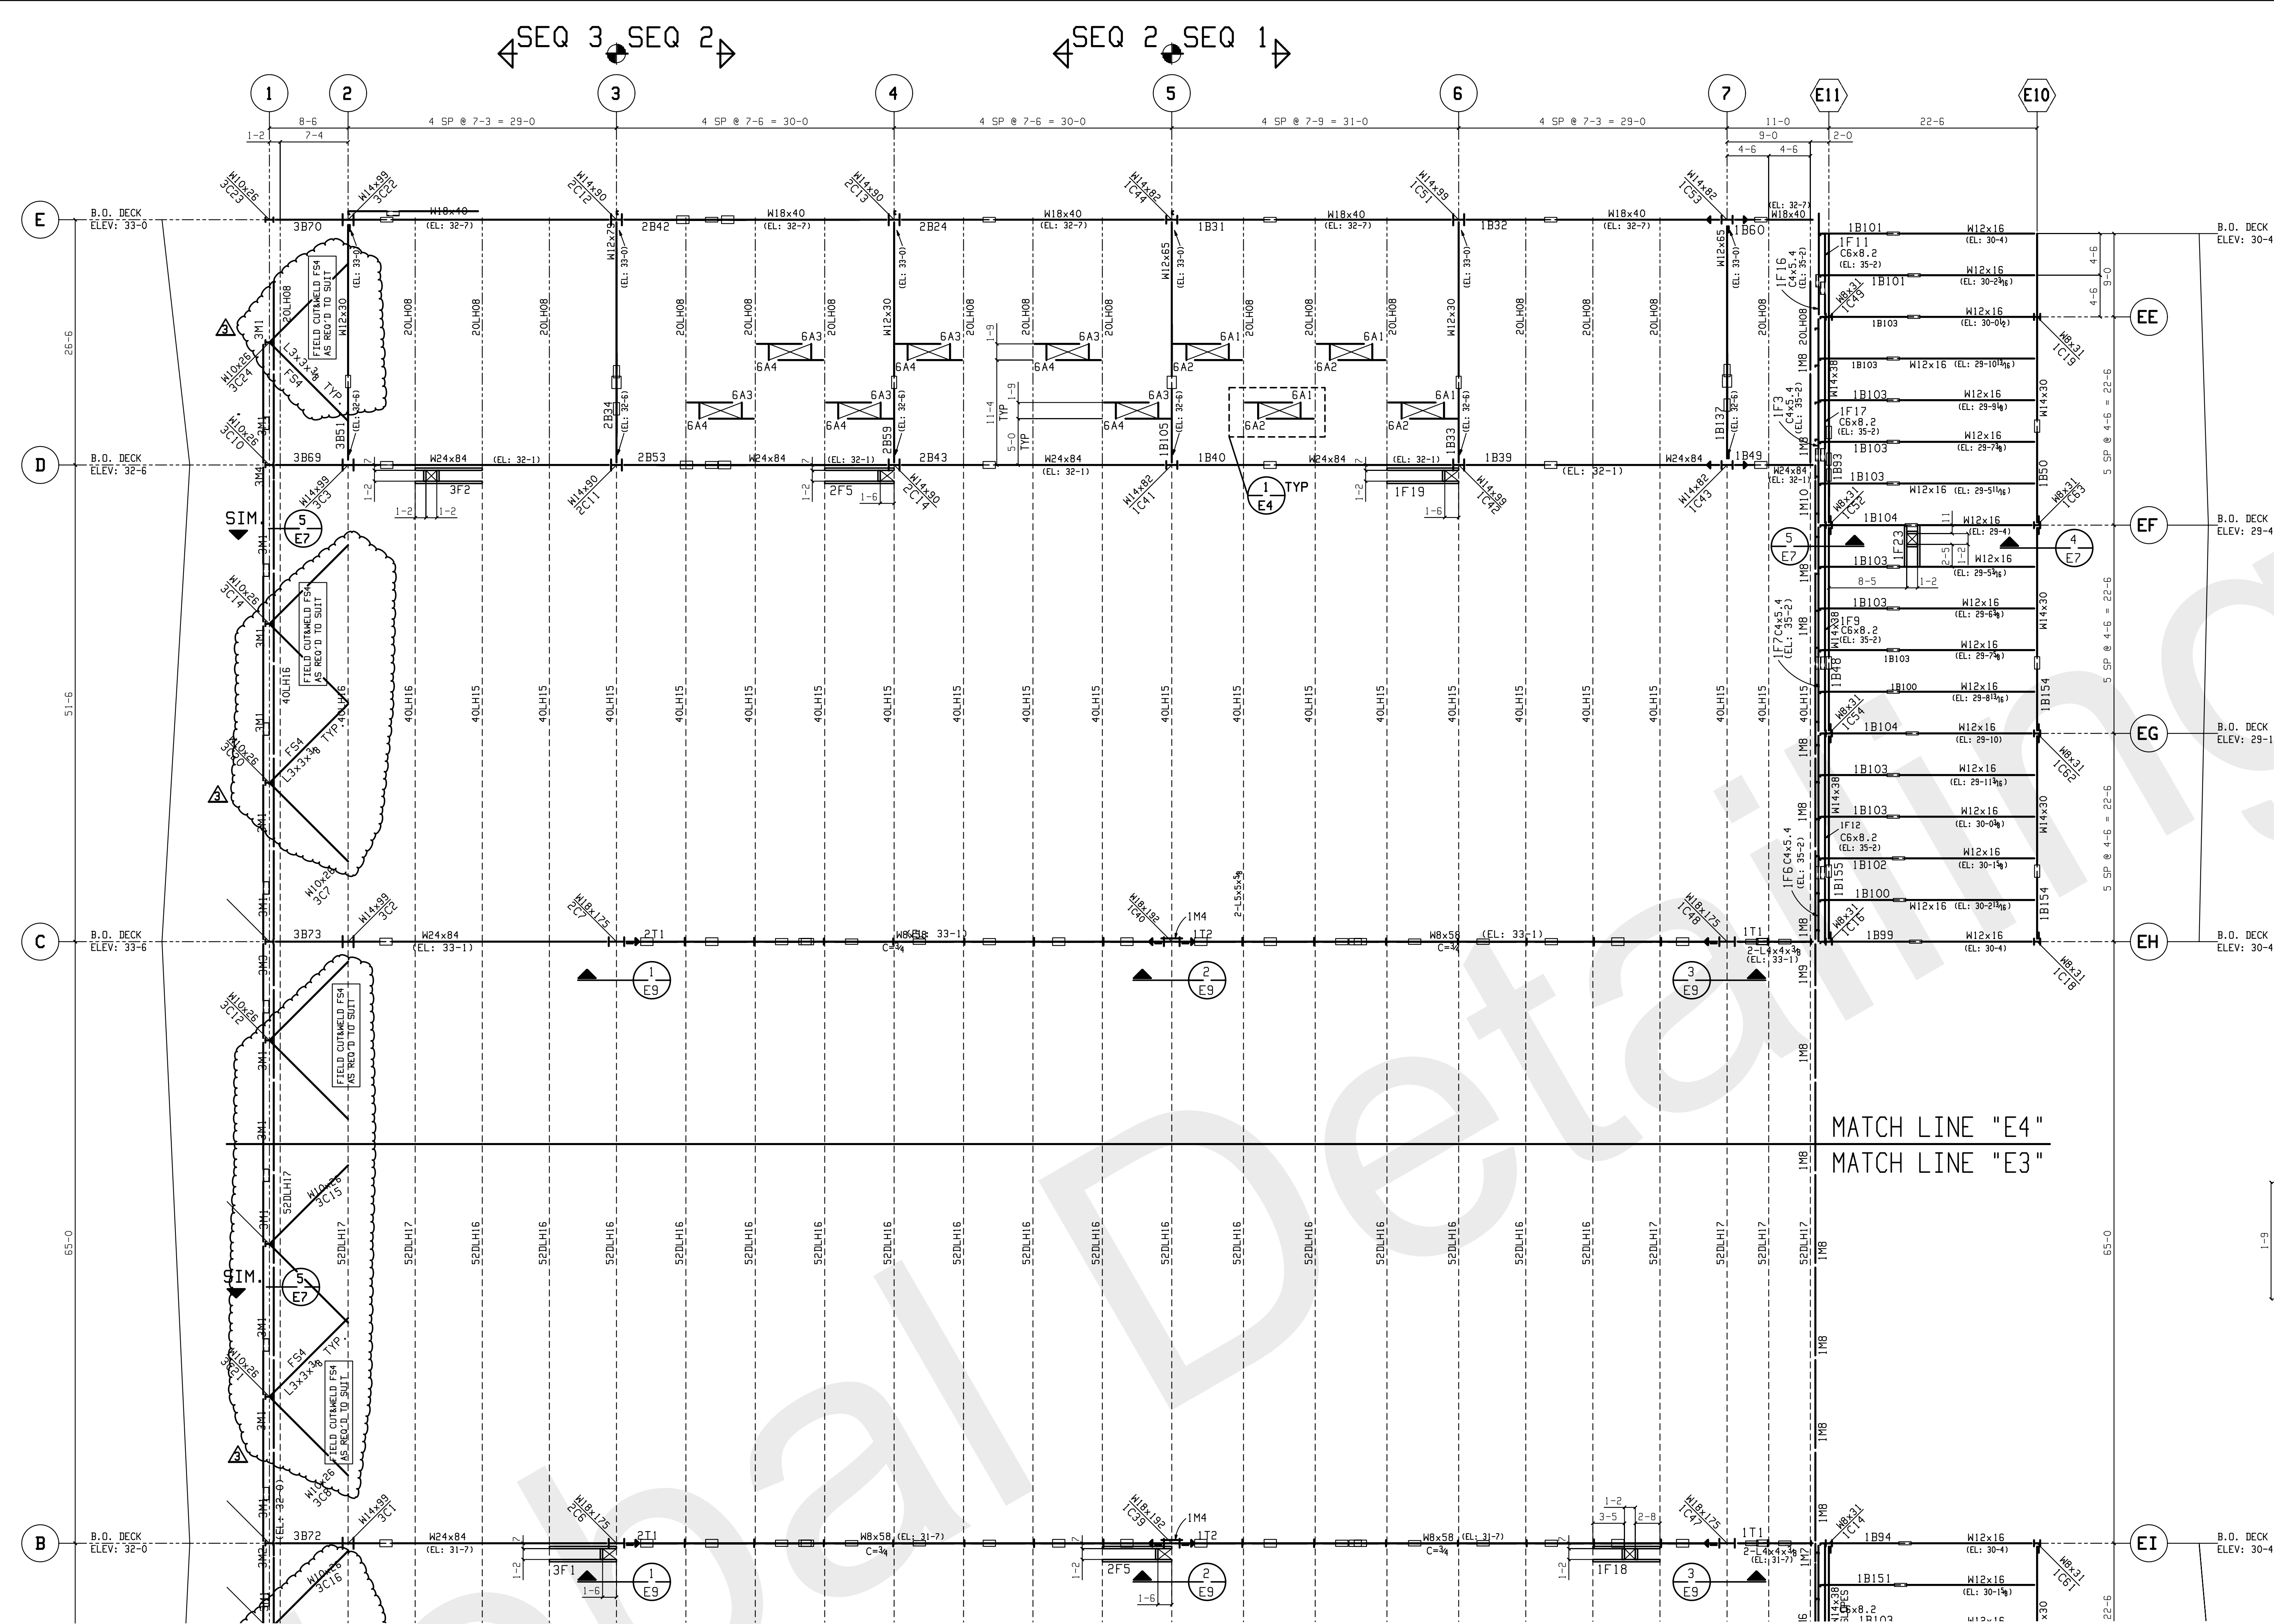

SECTION 1 E4


ALL VERIFIES, REQUEST FOR INFORMATION NOT RESPONDED TO AND/OR DIMENSIONS NOT FURNISHED WILL PLACE AFFECTED STEEL ON HOLD.

JEFFORDS STEEL AND ENGINEERING ASSUMES NO RESPONSIBILITY FOR ERRORS RESULTING FROM CONFLICTS IN CONTRACT DRAWINGS (ARCHITECTURAL/STRUCTURAL).

GENERAL NOTES:

CHARGES FOR CORRECTIVE WORK WILL NOT BE HONORED UNLESS PREVIOUS APPROVAL IS OBTAINED FROM JEFFORDS STEEL AND ENGINEERING COMPANY.

MEMBERS ARE TO BE ERECTED SO THAT MARKED END IS IN THE SAME LOCATION AS ON THE ERECTION DRAWING.

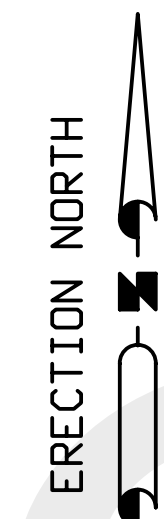

print record

1	APP	12-4	
1	APP	1-6	
1	FLO	4-12	

job no. 487

date 1-1-12

drawn by MC

checked by -

rev#	date	description
1	2-20-12	SHED ROOF SLOPES
2	3-5-12	ADDED ROOF FRAMES
3	3-22-12	ADDED BT 4" x 6" FIBER REINFORCED CONCRETE
4	3-29-12	ADDED ROOF FRAMES & SECTION

Customer

ENCOMPASS DEVELOP
DESIGN CONSTRUCTION


project

AKWESASNE MOHAWK CASINO
873 STATE HIGHWAY 37
AKWESASNE, NY


sheet

E4


Jeffords
STEEL AND ENGINEERING COMPANY
P.O. BOX 188 ROUTE 422
PITTSBURGH, NY 15201
518-561-4061

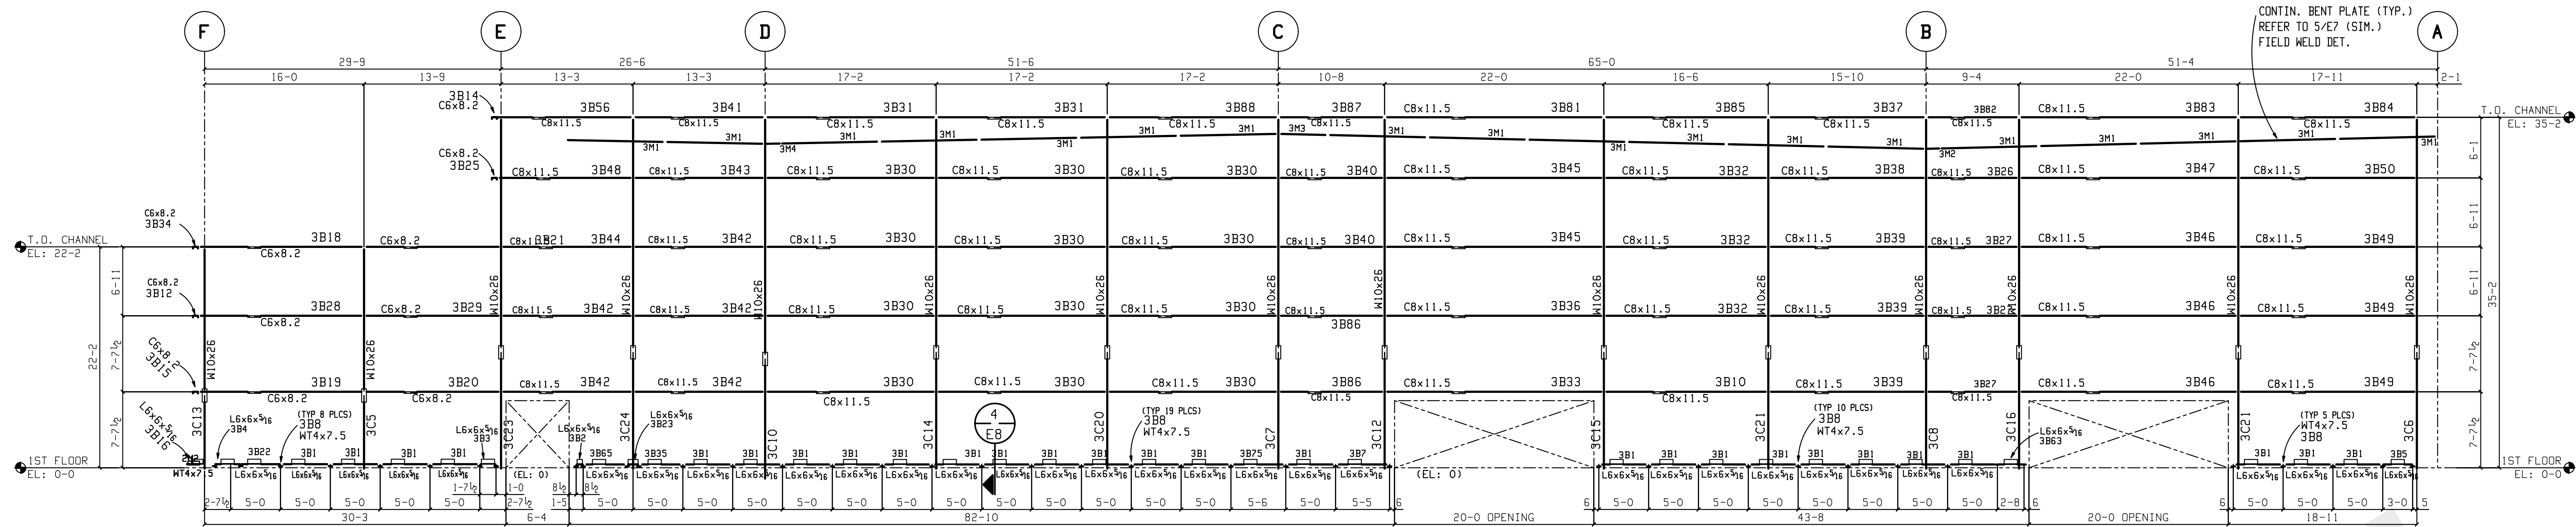


GIRT FRAMING @ COLUMNLINE 1
(LOOKING EAST)

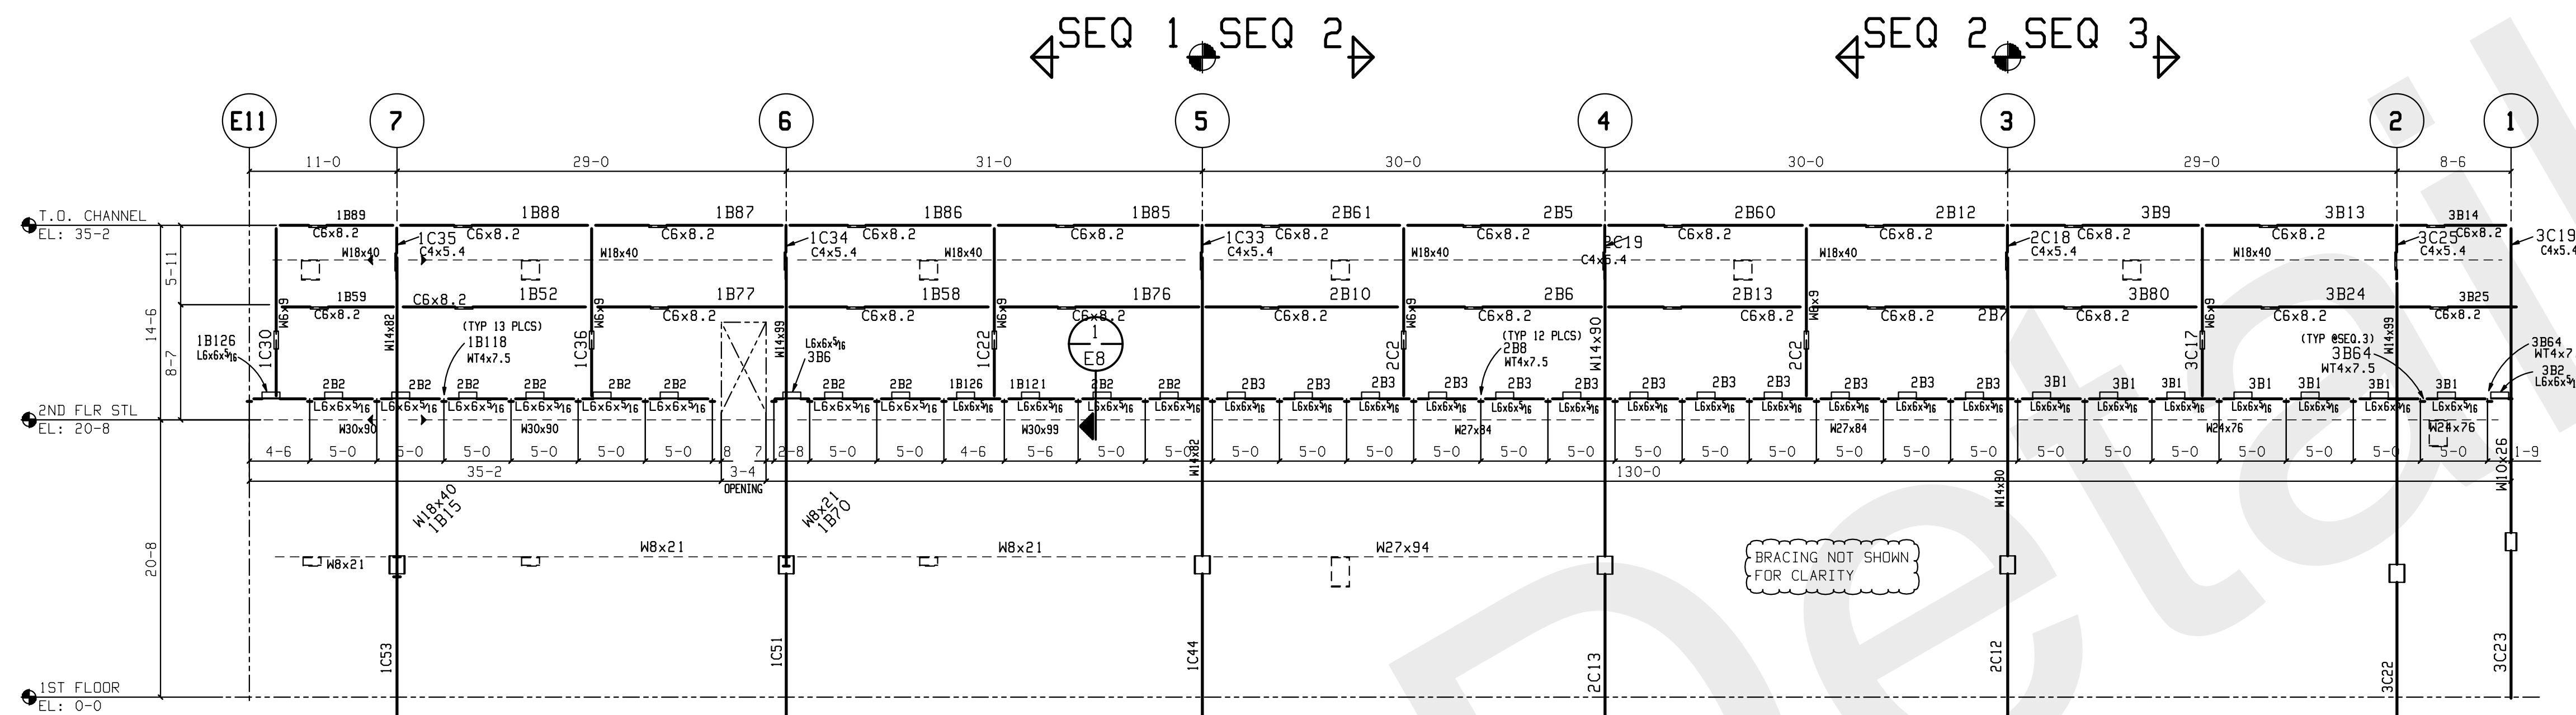


GIRT FRAMING @ COLUMNLINE E
(LOOKING SOUTH)

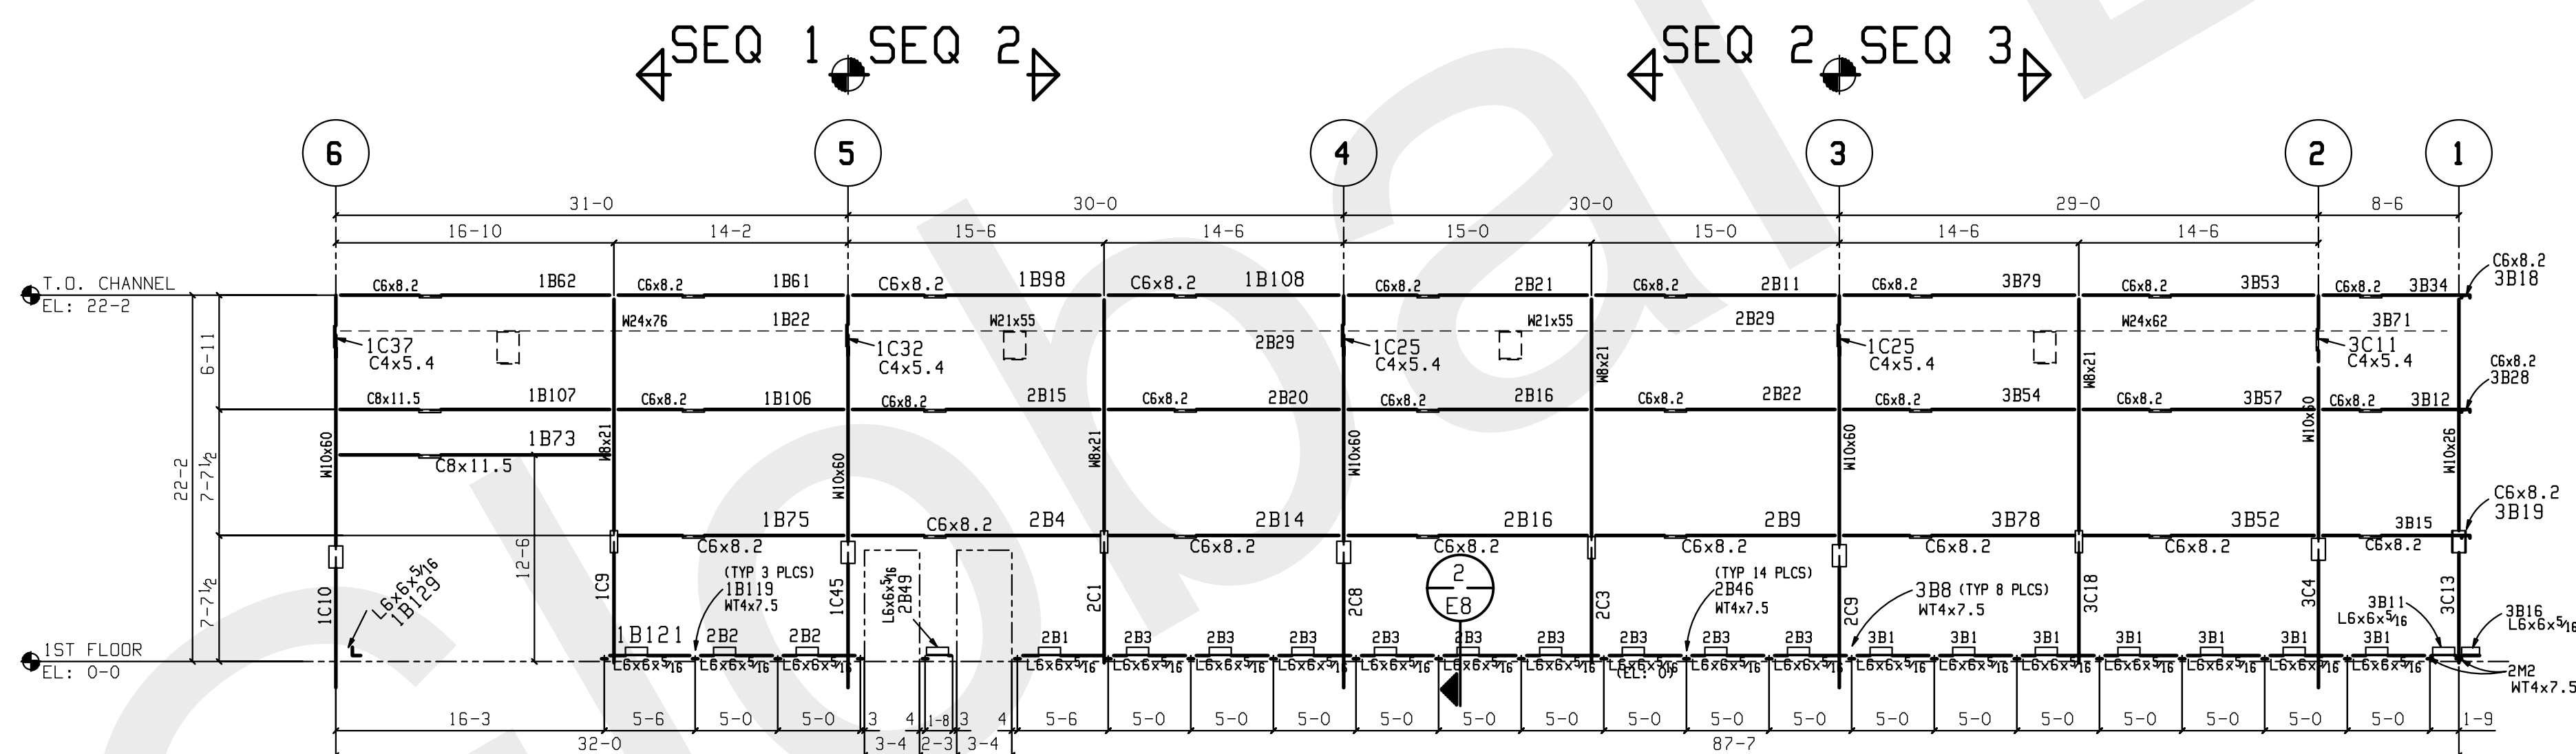

GIRT FRAMING @ COLUMNLINE F
(LOOKING SOUTH)

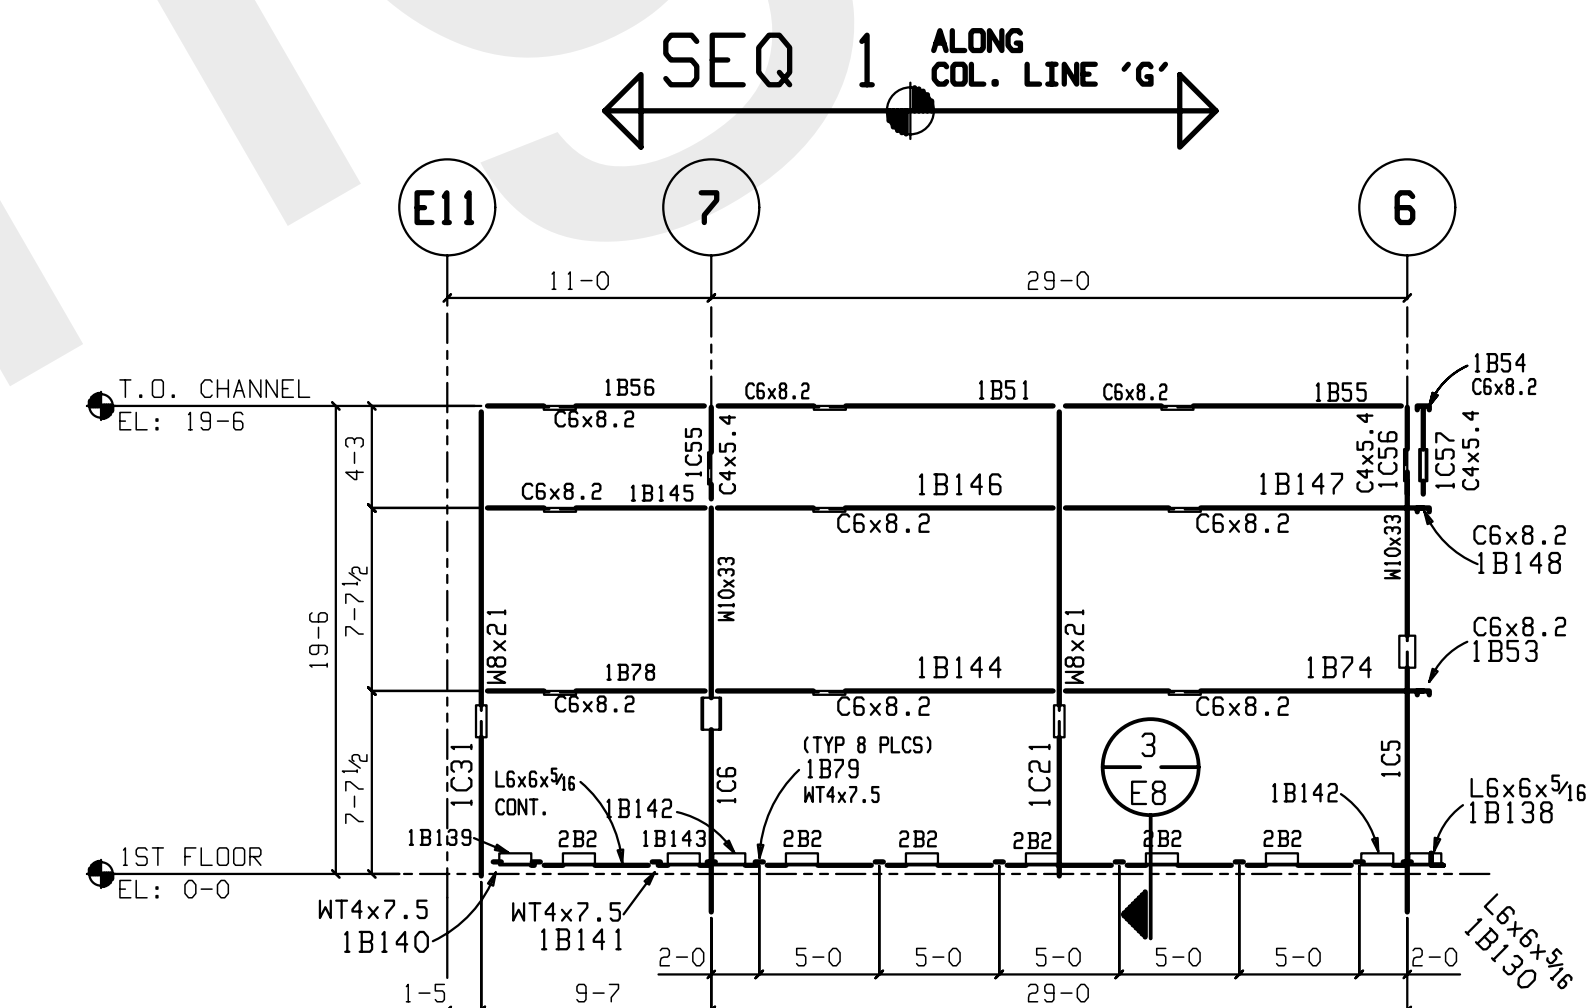

GIRT FRAMING @ COLUMNLINE G
(LOOKING SOUTH)

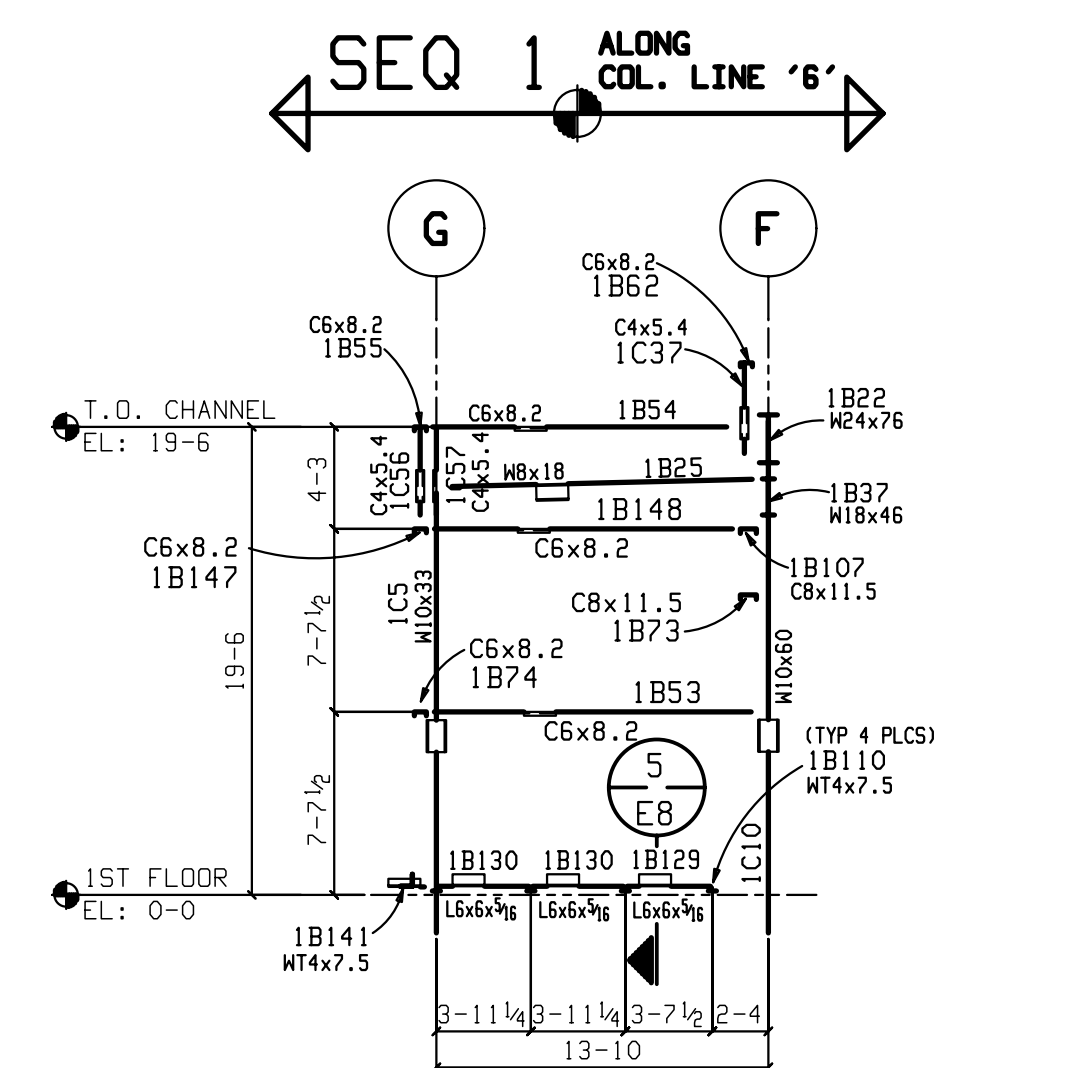

GIRT FRAMING @ COLUMNLINE 6
(LOOKING EAST)

ALL VERIFIES, REQUEST FOR INFORMATION NOT RESPONDED TO AND/OR DIMENSIONS NOT FURNISHED WILL PLACE AFFECTED STEEL ON HOLD.

JEFFORDS STEEL AND ENGINEERING ASSUMES NO RESPONSIBILITY FOR ERRORS RESULTING FROM CONFLICTS IN CONTRACT DRAWINGS (ARCHITECTURAL/STRUCTURAL).

GENERAL NOTES:

CHARGES FOR CORRECTIVE WORK WILL NOT BE HONORED UNLESS PREVIOUS APPROVAL IS OBTAINED FROM JEFFORDS STEEL AND ENGINEERING COMPANY.

MEMBERS ARE TO BE ERCTED SO THAT MARKED END IS IN THE SAME LOCATION AS ON THE ERECTION DRAWING.

print record			
1	APP	12-4	
1	APP	1-6	
1	FIELD	2-16	


revisions			
rev#	date	description	

Customer: ENCOMPASS DEVELOP
DESIGN CONSTRUCTION


Project: AKWESASNE MOHAWK CASINO
873 STATE HIGHWAY 37
AKWESASNE, NY

sheet: E5


JEFFORDS
STEEL AND ENGINEERING COMPANY
P.O. BOX 188, ROUTE 422
PITTSBURGH, NY 15201
518-561-4061

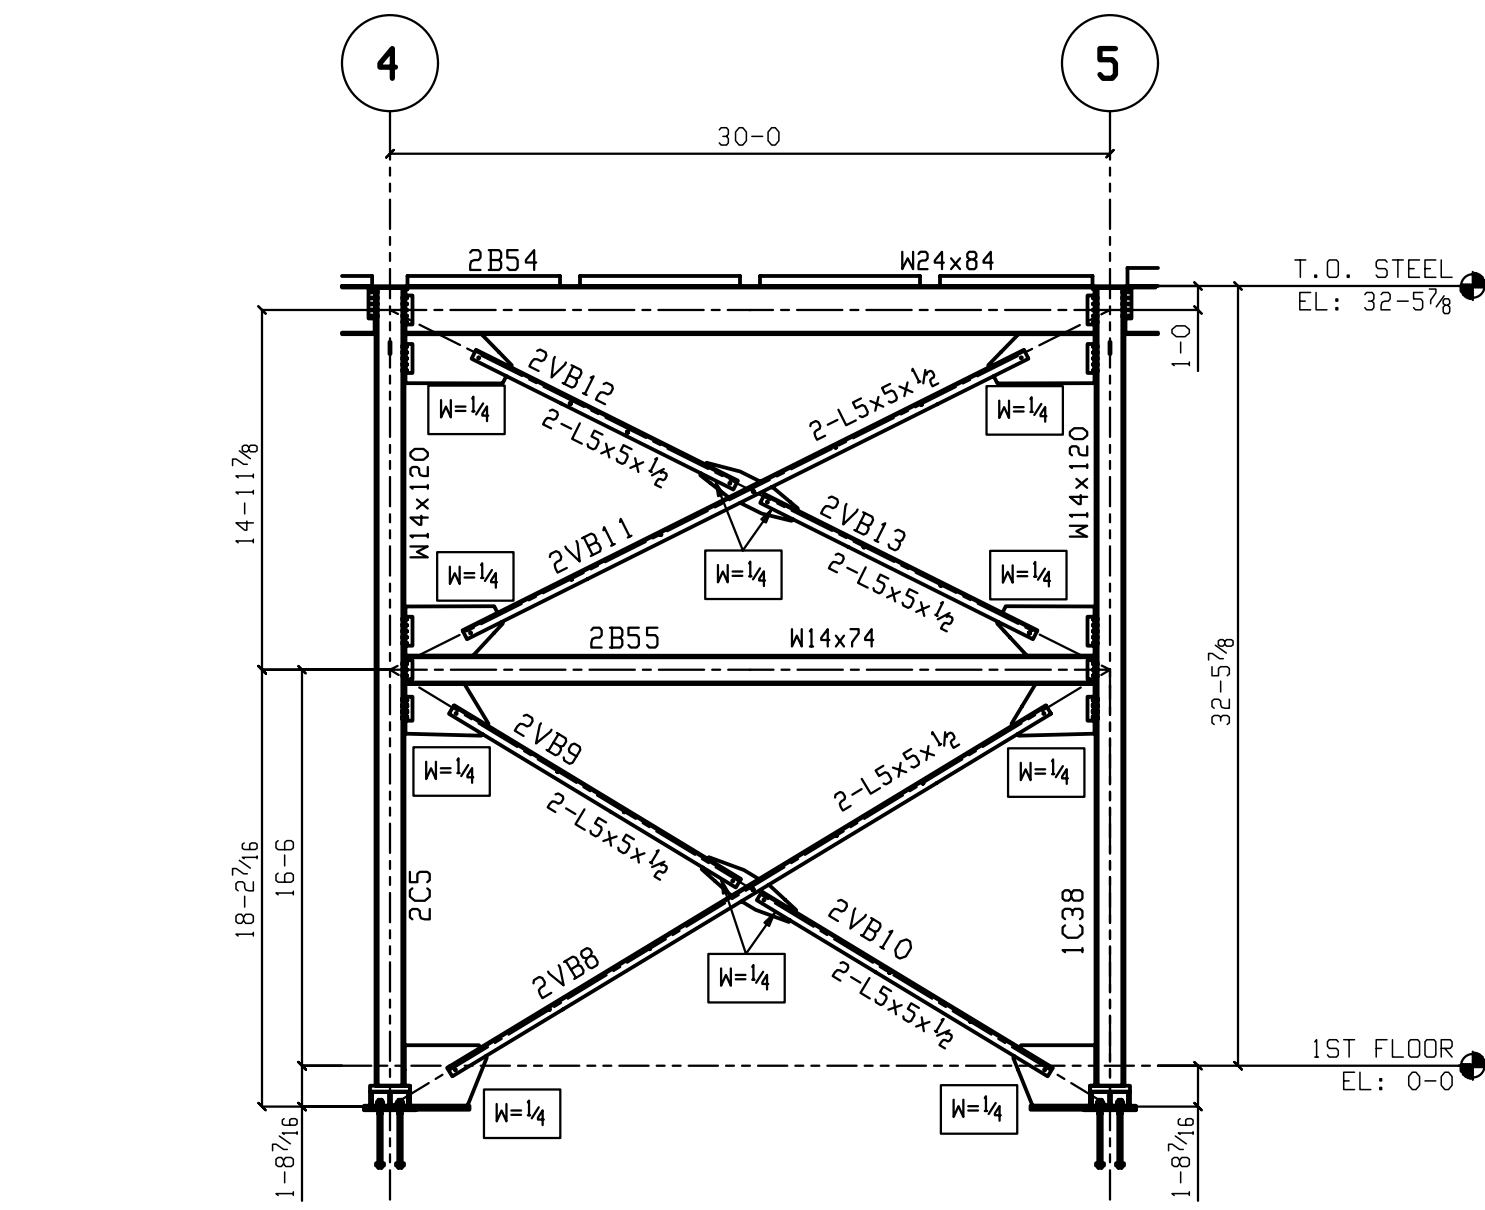


VERTICAL BRACE @ COLUMNLINE A
(LOOKING NORTH) (REF: 2/530-01-02)

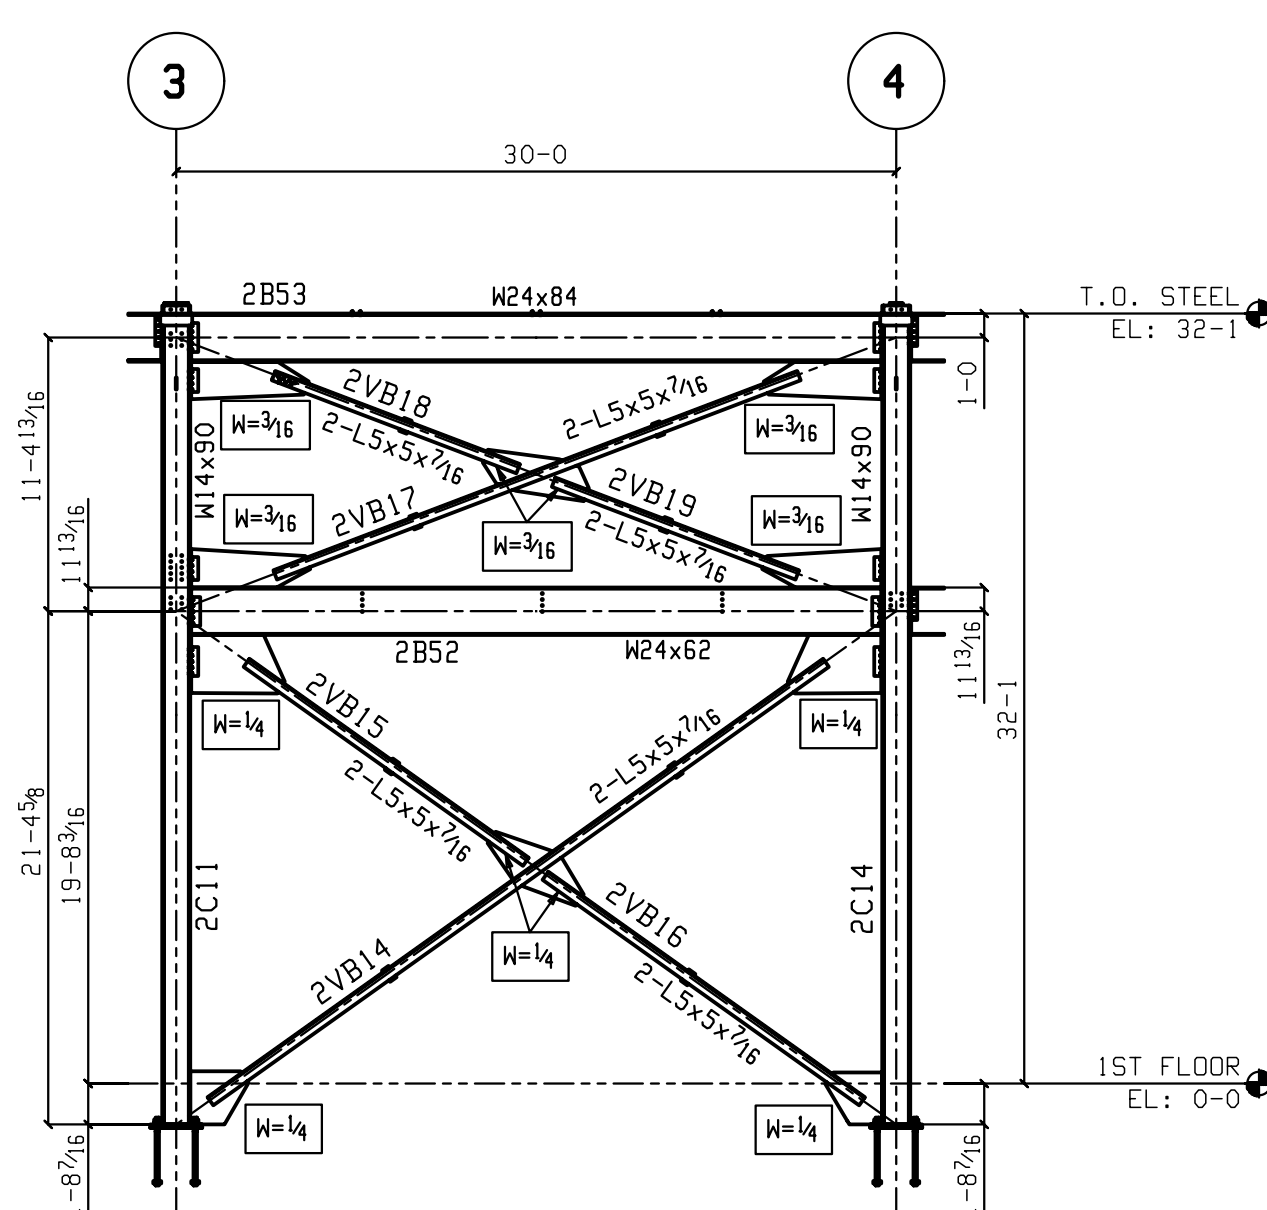


VERTICAL BRACE @ COLUMNLINE D
(LOOKING NORTH) (REF: 2/530-01-03)

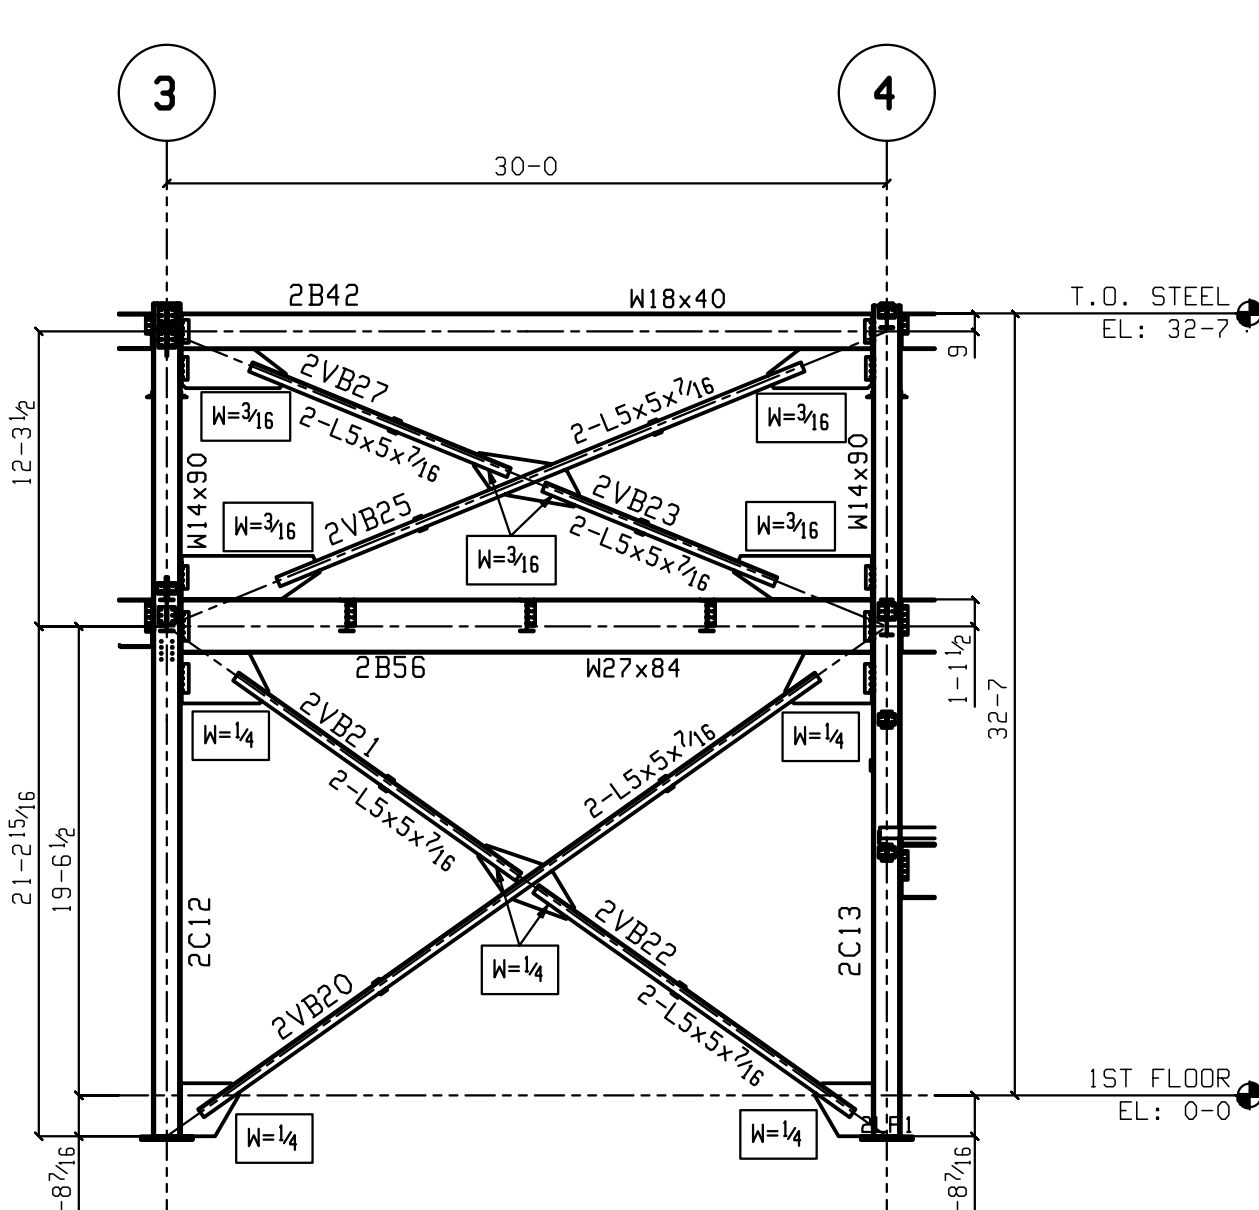


VERTICAL BRACE @ COLUMNLINE E
(LOOKING NORTH) (REF: 2/530-01-03)

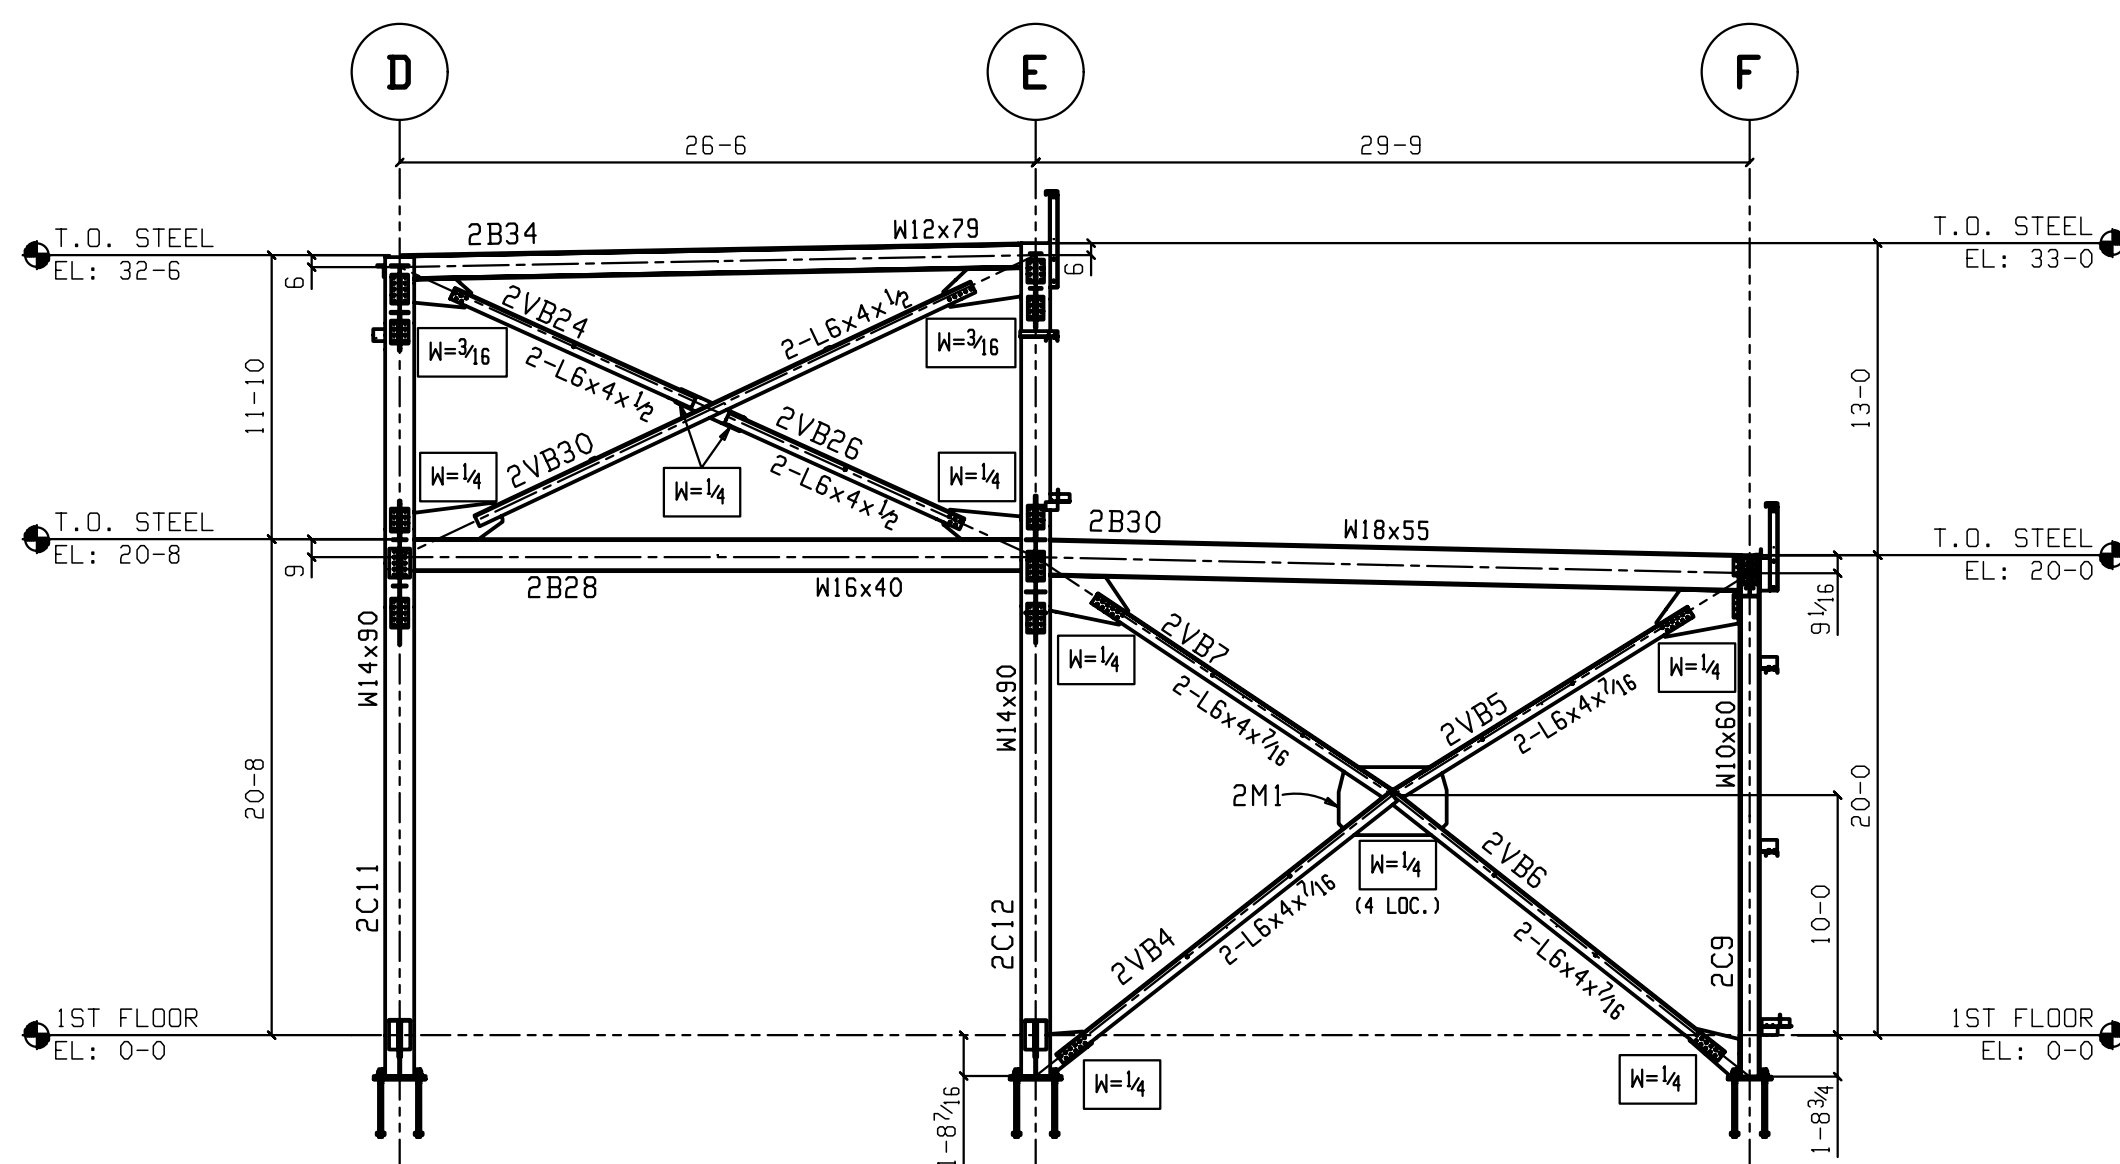


VERTICAL BRACE @ COLUMNLINE 3
(LOOKING WEST) (REF: 1 & 2/530-01-04)

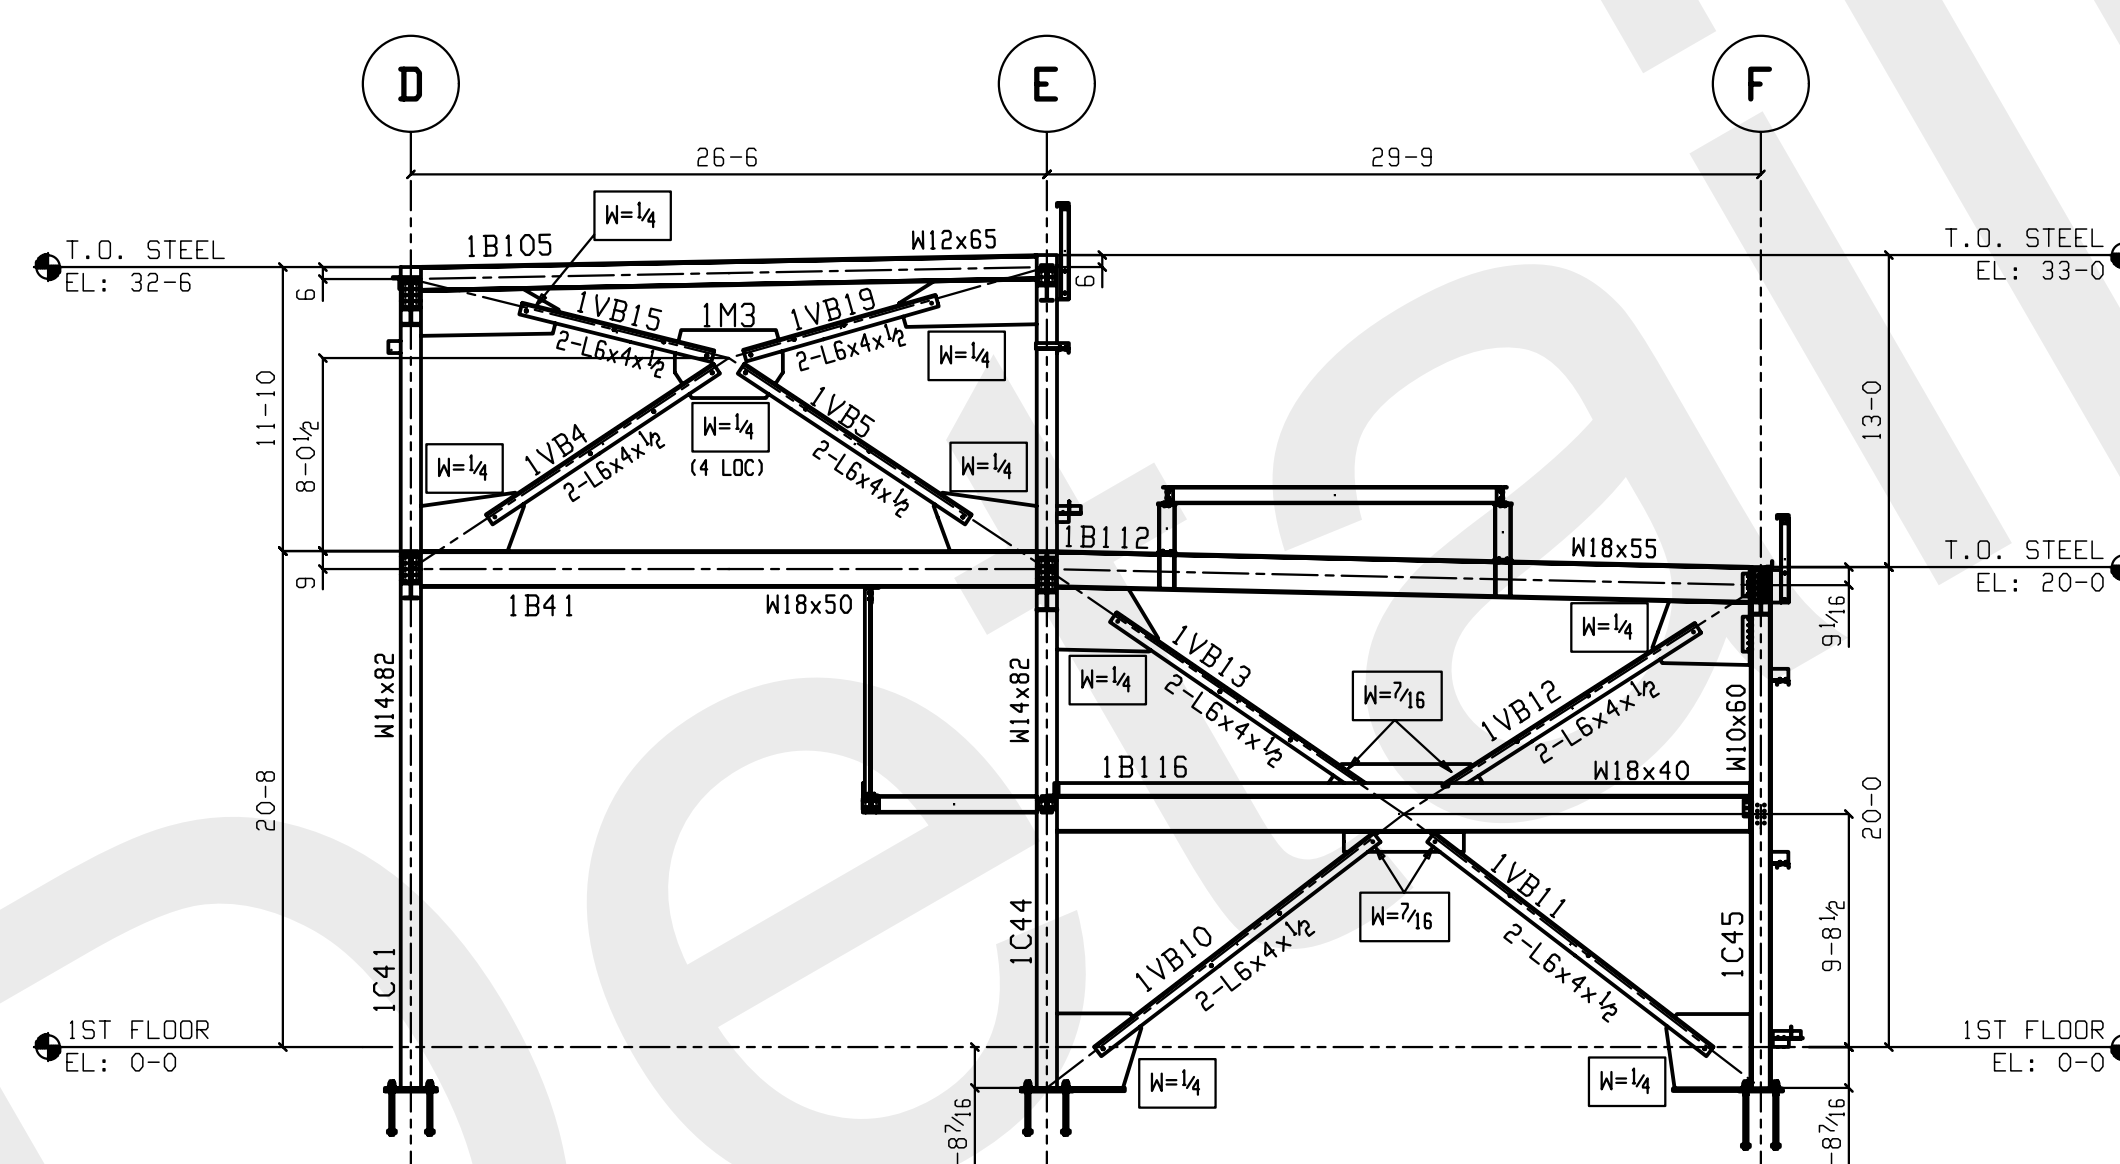


VERTICAL BRACE @ COLUMNLINE 5
(LOOKING WEST) (REF: 1/530-01-04)

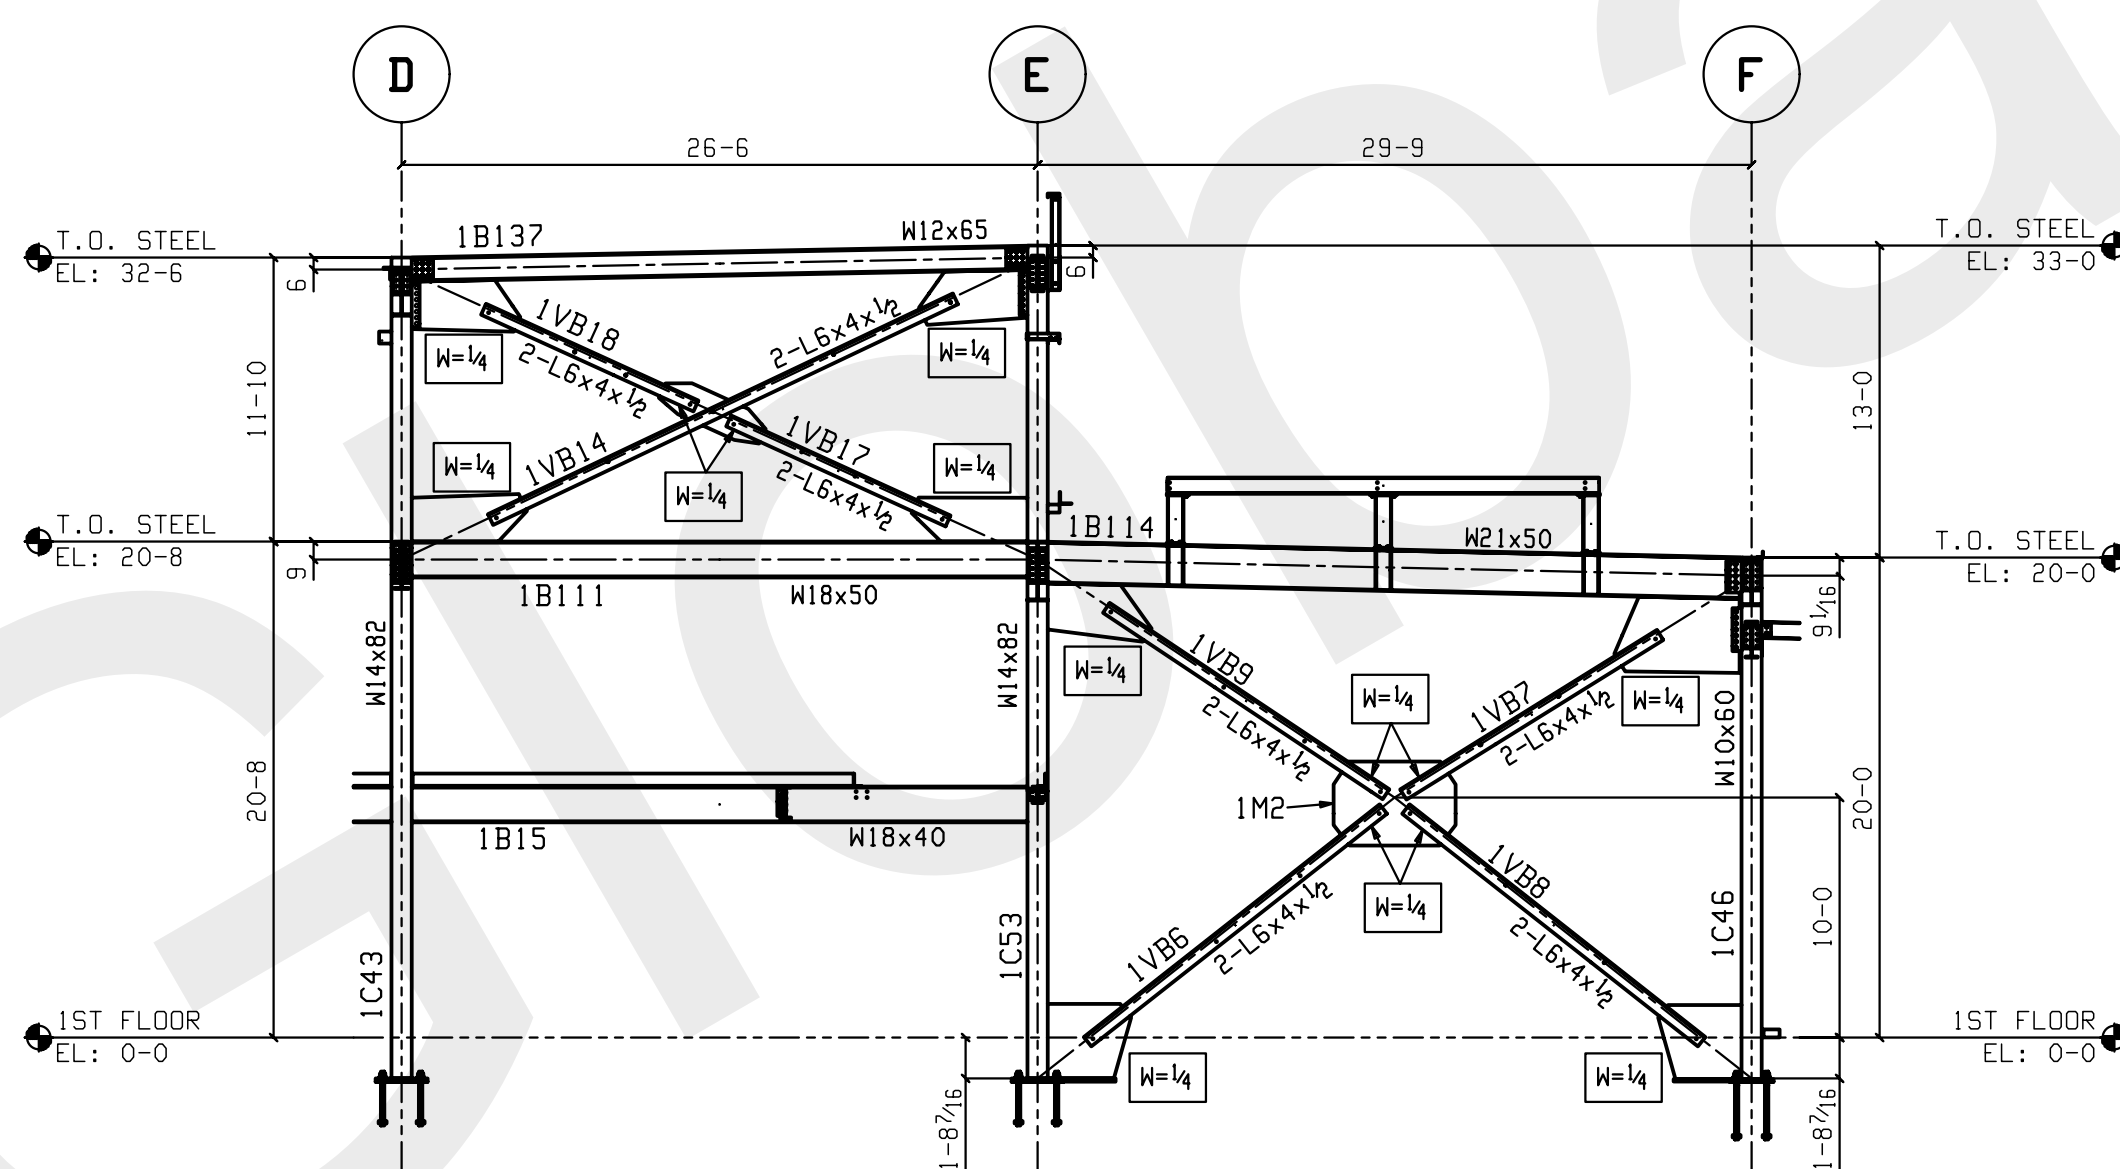

VERTICAL BRACE @ COLUMNLINE 7
(LOOKING WEST) (REF: 1/530-01-04)

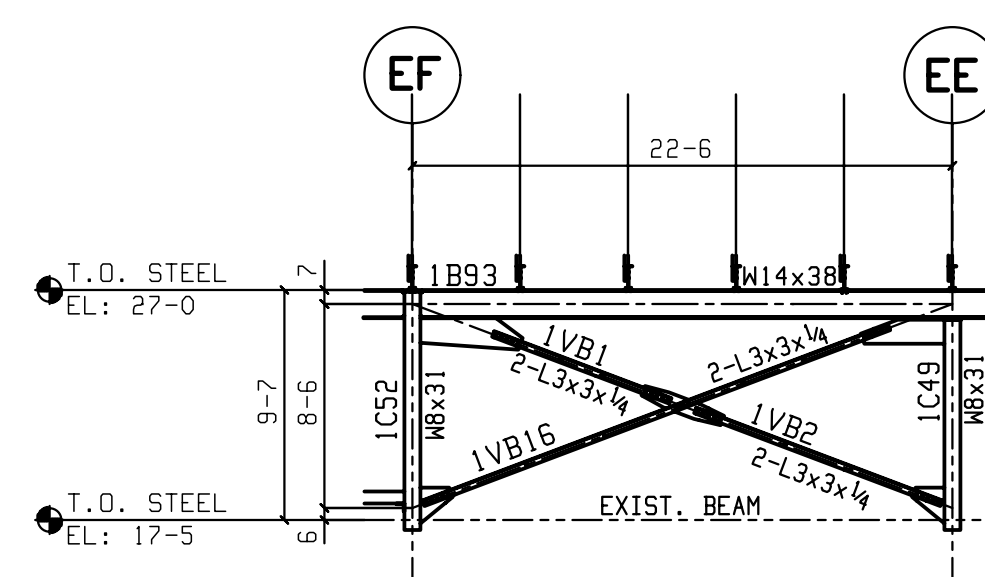

VERTICAL BRACE @ COLUMNLINE E11
(LOOKING WEST) (REF: 3/530-01-04)
THIS BRACE FRAME HAS ALL BOLTED CONNECTIONS

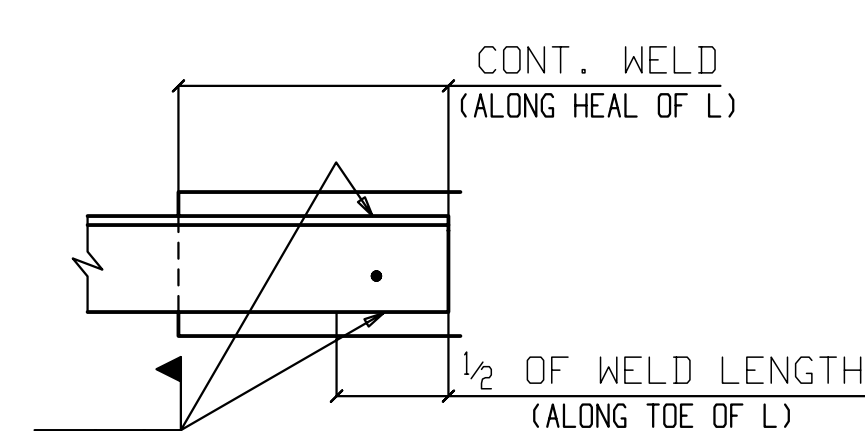

TYPICAL WELD CONNECTION AT
BRACE ANGLE TO GUSSET PLATE
NOTE: W = WELD SIZE
(SEE BRACING ELEVATIONS)

ALL VERIFIES, REQUEST FOR INFORMATION NOT RESPONDED TO AND/OR DIMENSIONS NOT FURNISHED WILL PLACE AFFECTED STEEL ON HOLD.
JEFFORDS STEEL AND ENGINEERING ASSUMES NO RESPONSIBILITY FOR ERRORS RESULTING FROM CONFLICTS IN CONTRACT DRAWINGS (ARCHITECTURAL/STRUCTURAL).

GENERAL NOTES:
CHARGES FOR CORRECTIVE WORK WILL NOT BE HONORED UNLESS PREVIOUS APPROVAL IS OBTAINED FROM JEFFORDS STEEL AND ENGINEERING COMPANY.
MEMBERS ARE TO BE ERRECTED SO THAT MARKED END IS IN THE SAME LOCATION AS ON THE ERECTION DRAWING.



print record	1	APP	12-4
1	1	APP	1-6
1	1	FIELD	2-16

job no. 487	date 1-4-12	drawn by MC	checked by - COT
-------------	-------------	-------------	------------------

revisions	description
rev#	date
1	3.6.12
	ADDED TYPICAL WELD DETAIL & SIZES

JEFFORDS
STEEL AND ENGINEERING COMPANY
P.O. BOX 488 ROUTE 422
PITTSBURGH, NY 15201
518-561-4061

ENCOMPASS DEVELOP
DESIGN CONSTRUCTION

AKWESASNE MOHAWK CASINO
873 STATE HIGHWAY 37
AKWESASNE, NY

sheet
E6

print record			
1	APP	12-4	
1	APP	1-6	
1	FIELD	2-16	

job no. 487	date 1-12	drawn by MC	checked by -GII
-------------	-----------	-------------	-----------------



revisions	description	date	rev#

JEFFORDS
STEEL AND ENGINEERING COMPANY
P.O. BOX 188 ROUTE 422
PITTSBURGH, N.Y. 15201
518-561-4061


CUSTOMER
ENCOMPASS DEVELOP
DESIGN CONSTRUCTION

PROJECT
AKWESASNE MOHAWK CASINO
873 STATE HIGHWAY 37
AKWESASNE, NY


SHEET
E7

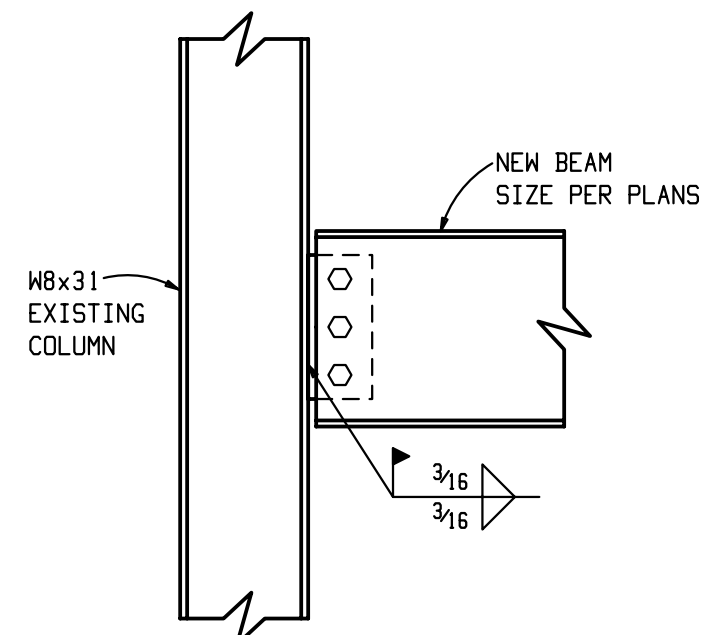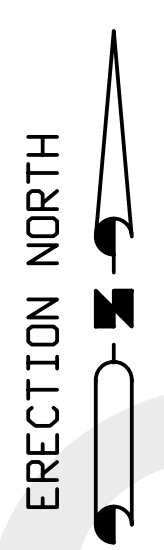


1 SECTION
E7

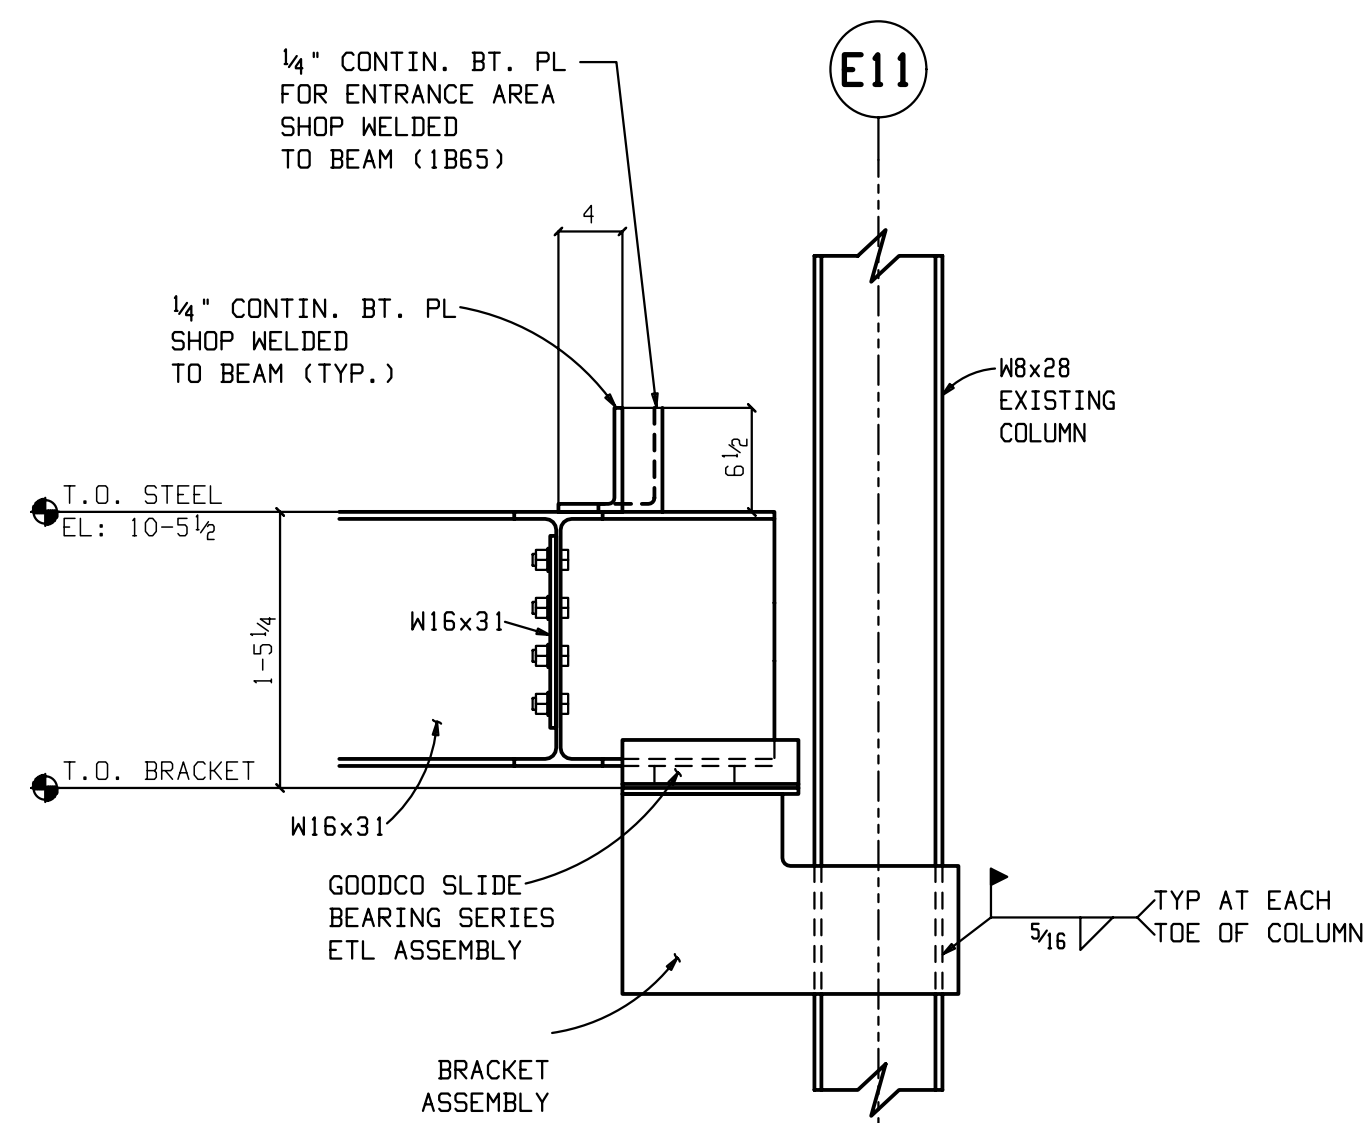


2 SECTION
E7 (REF: 1/SSO-01-01)

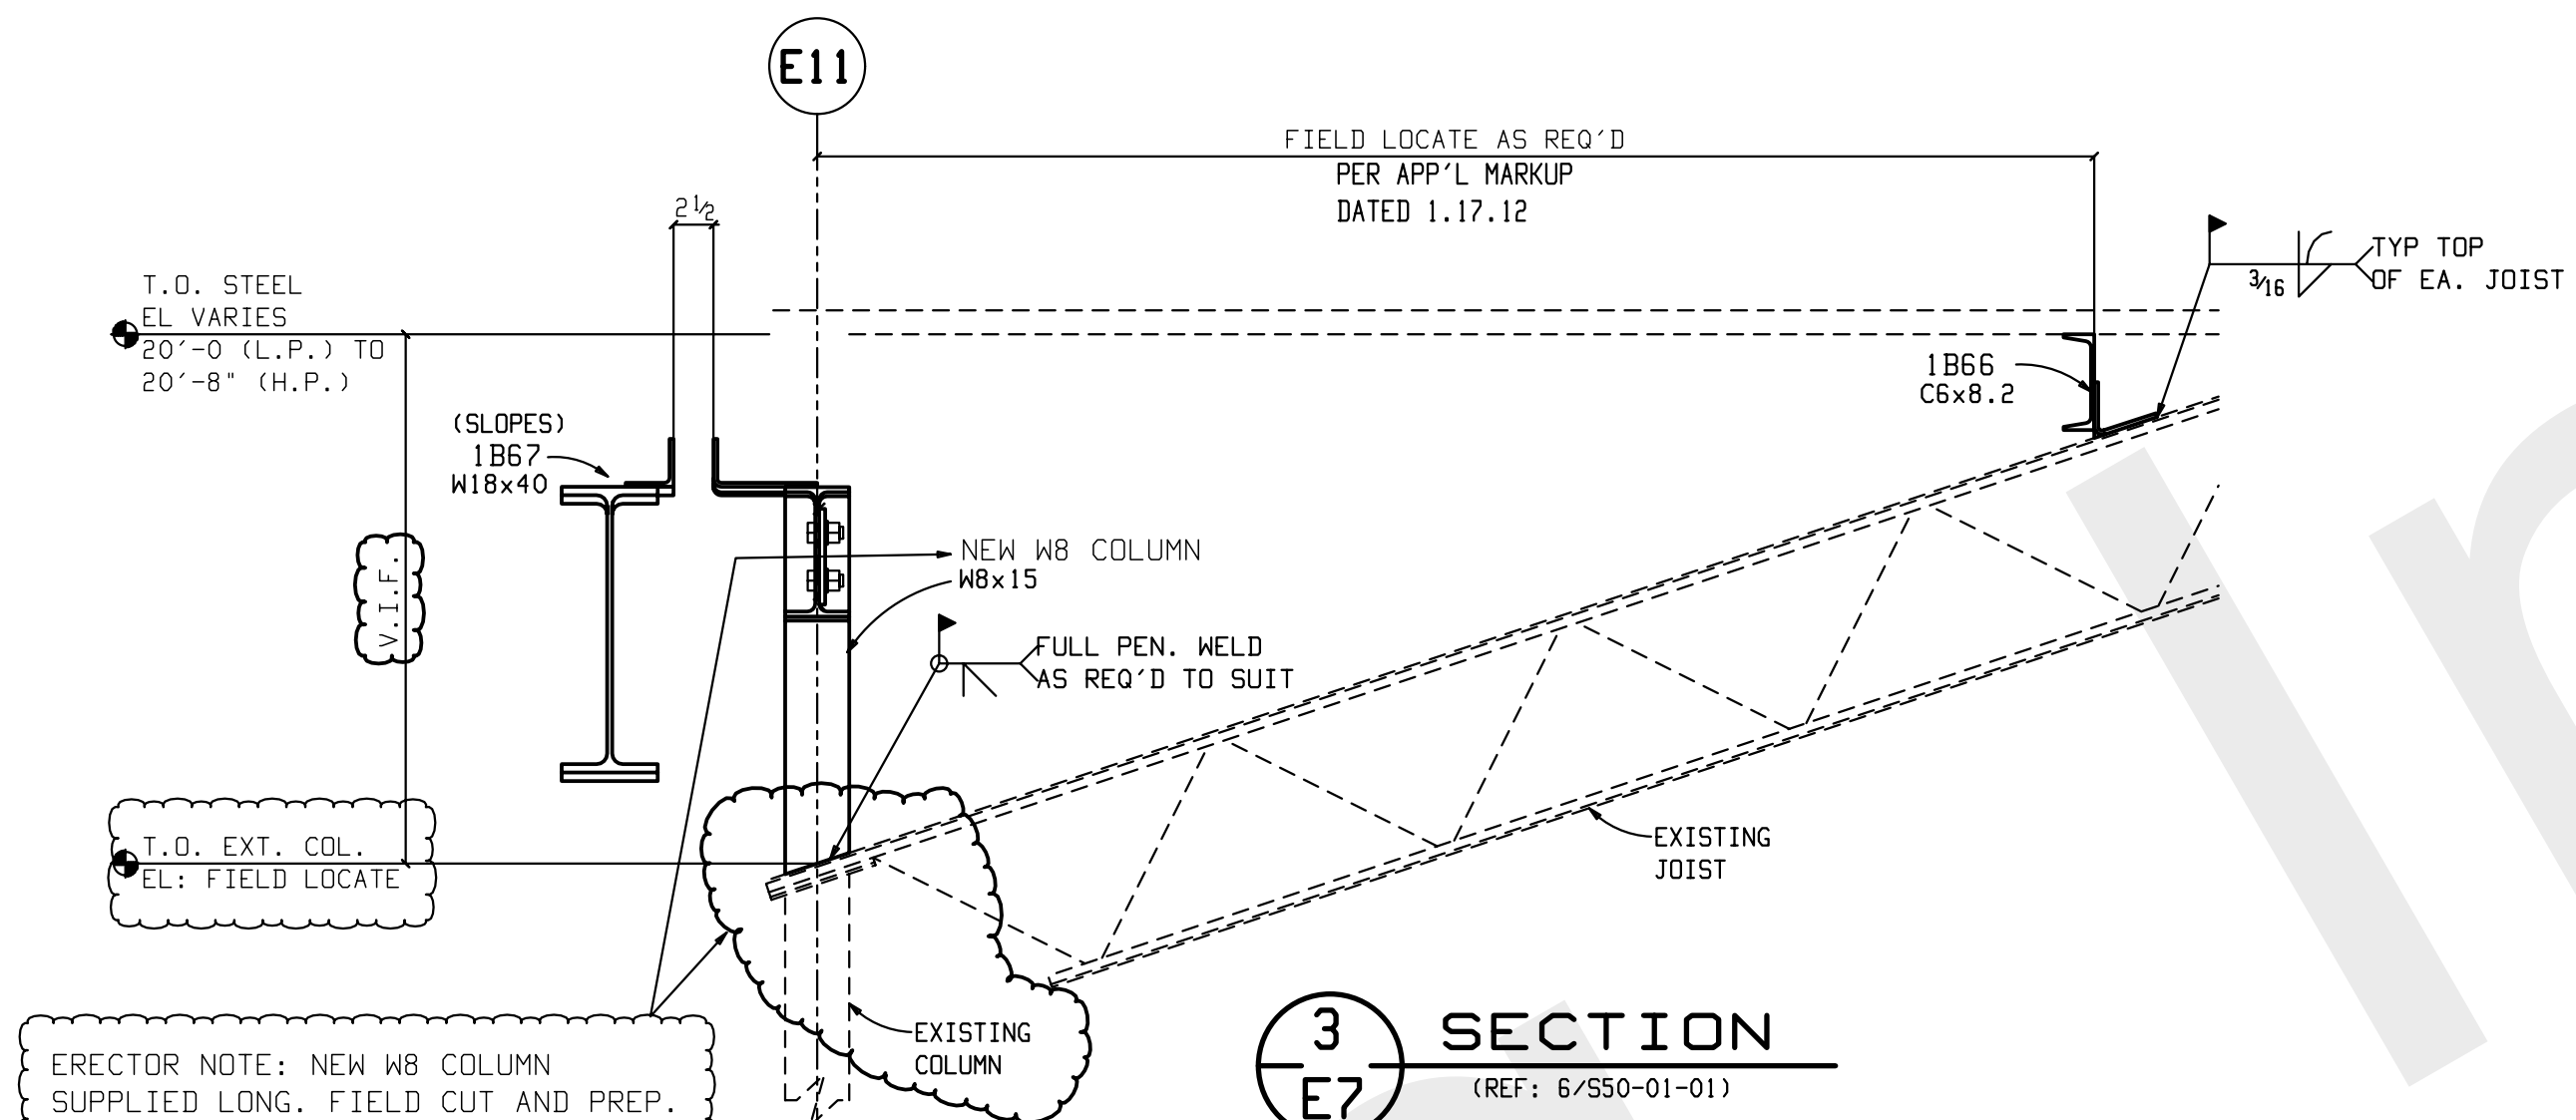


3 SECTION
E7 (REF: 6/SSO-01-01)

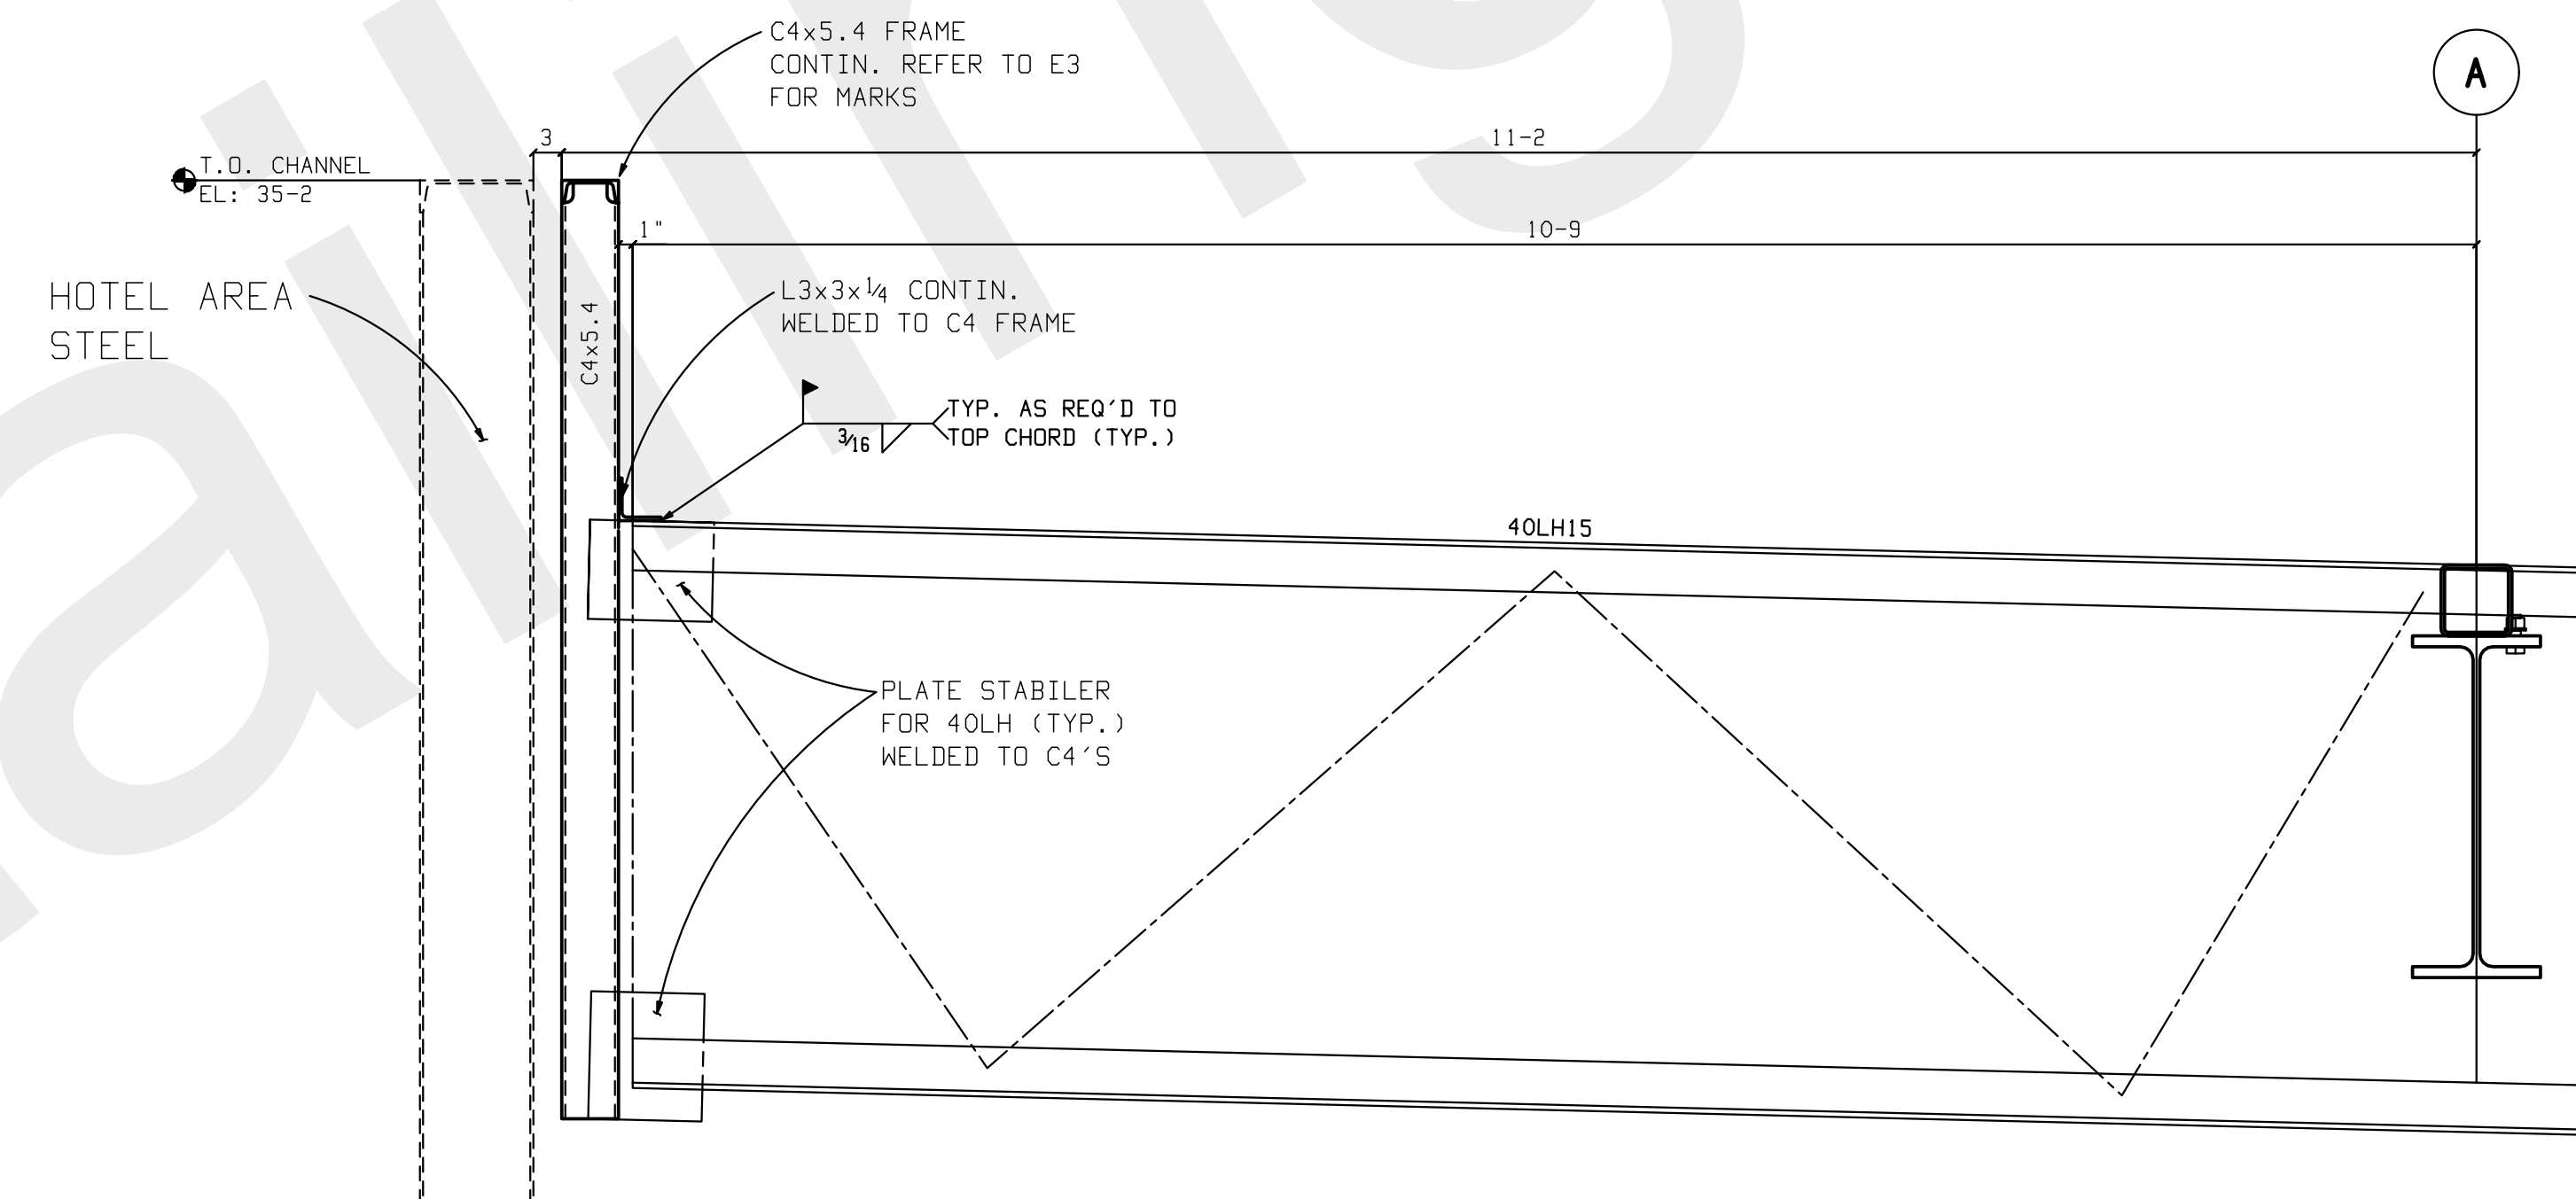


6 SECTION
E7

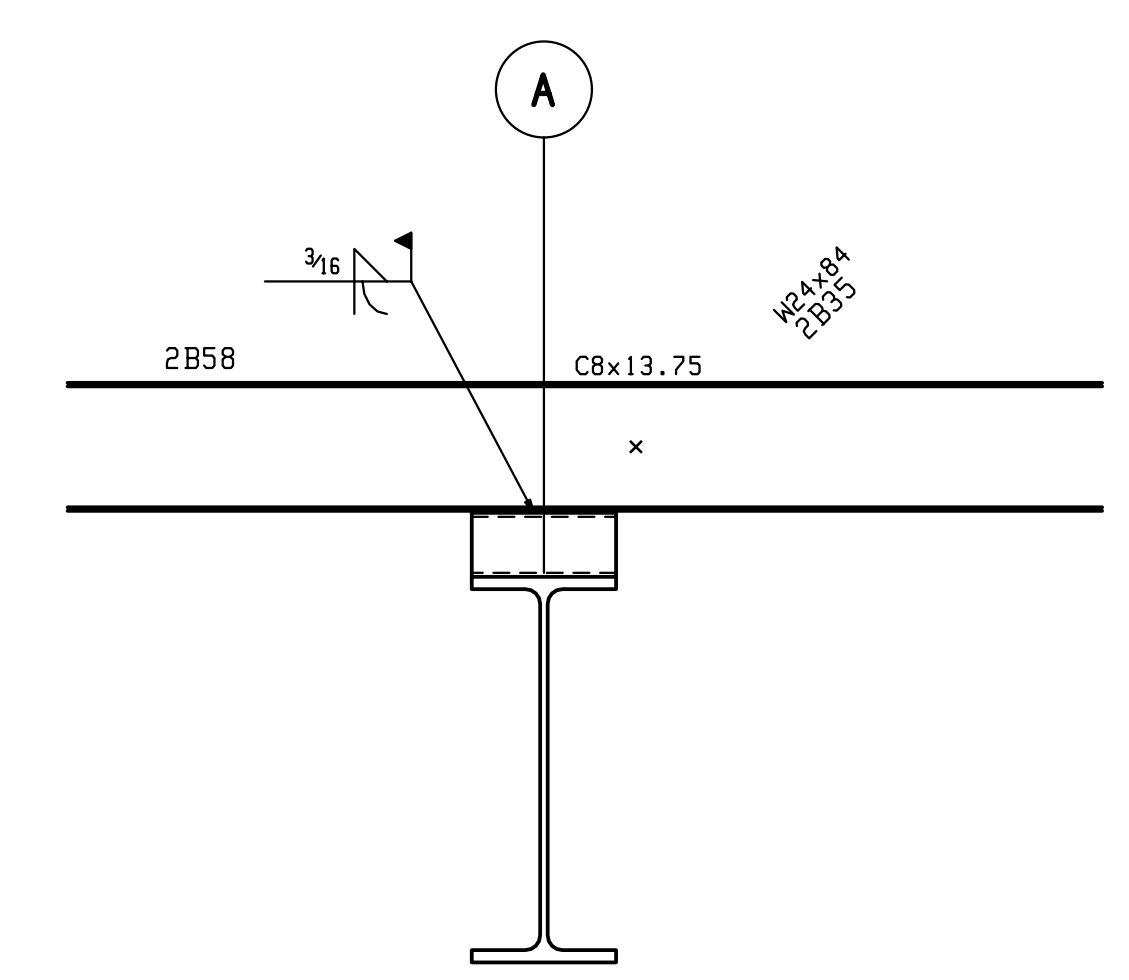

7 SECTION
E7 (REF: E3)

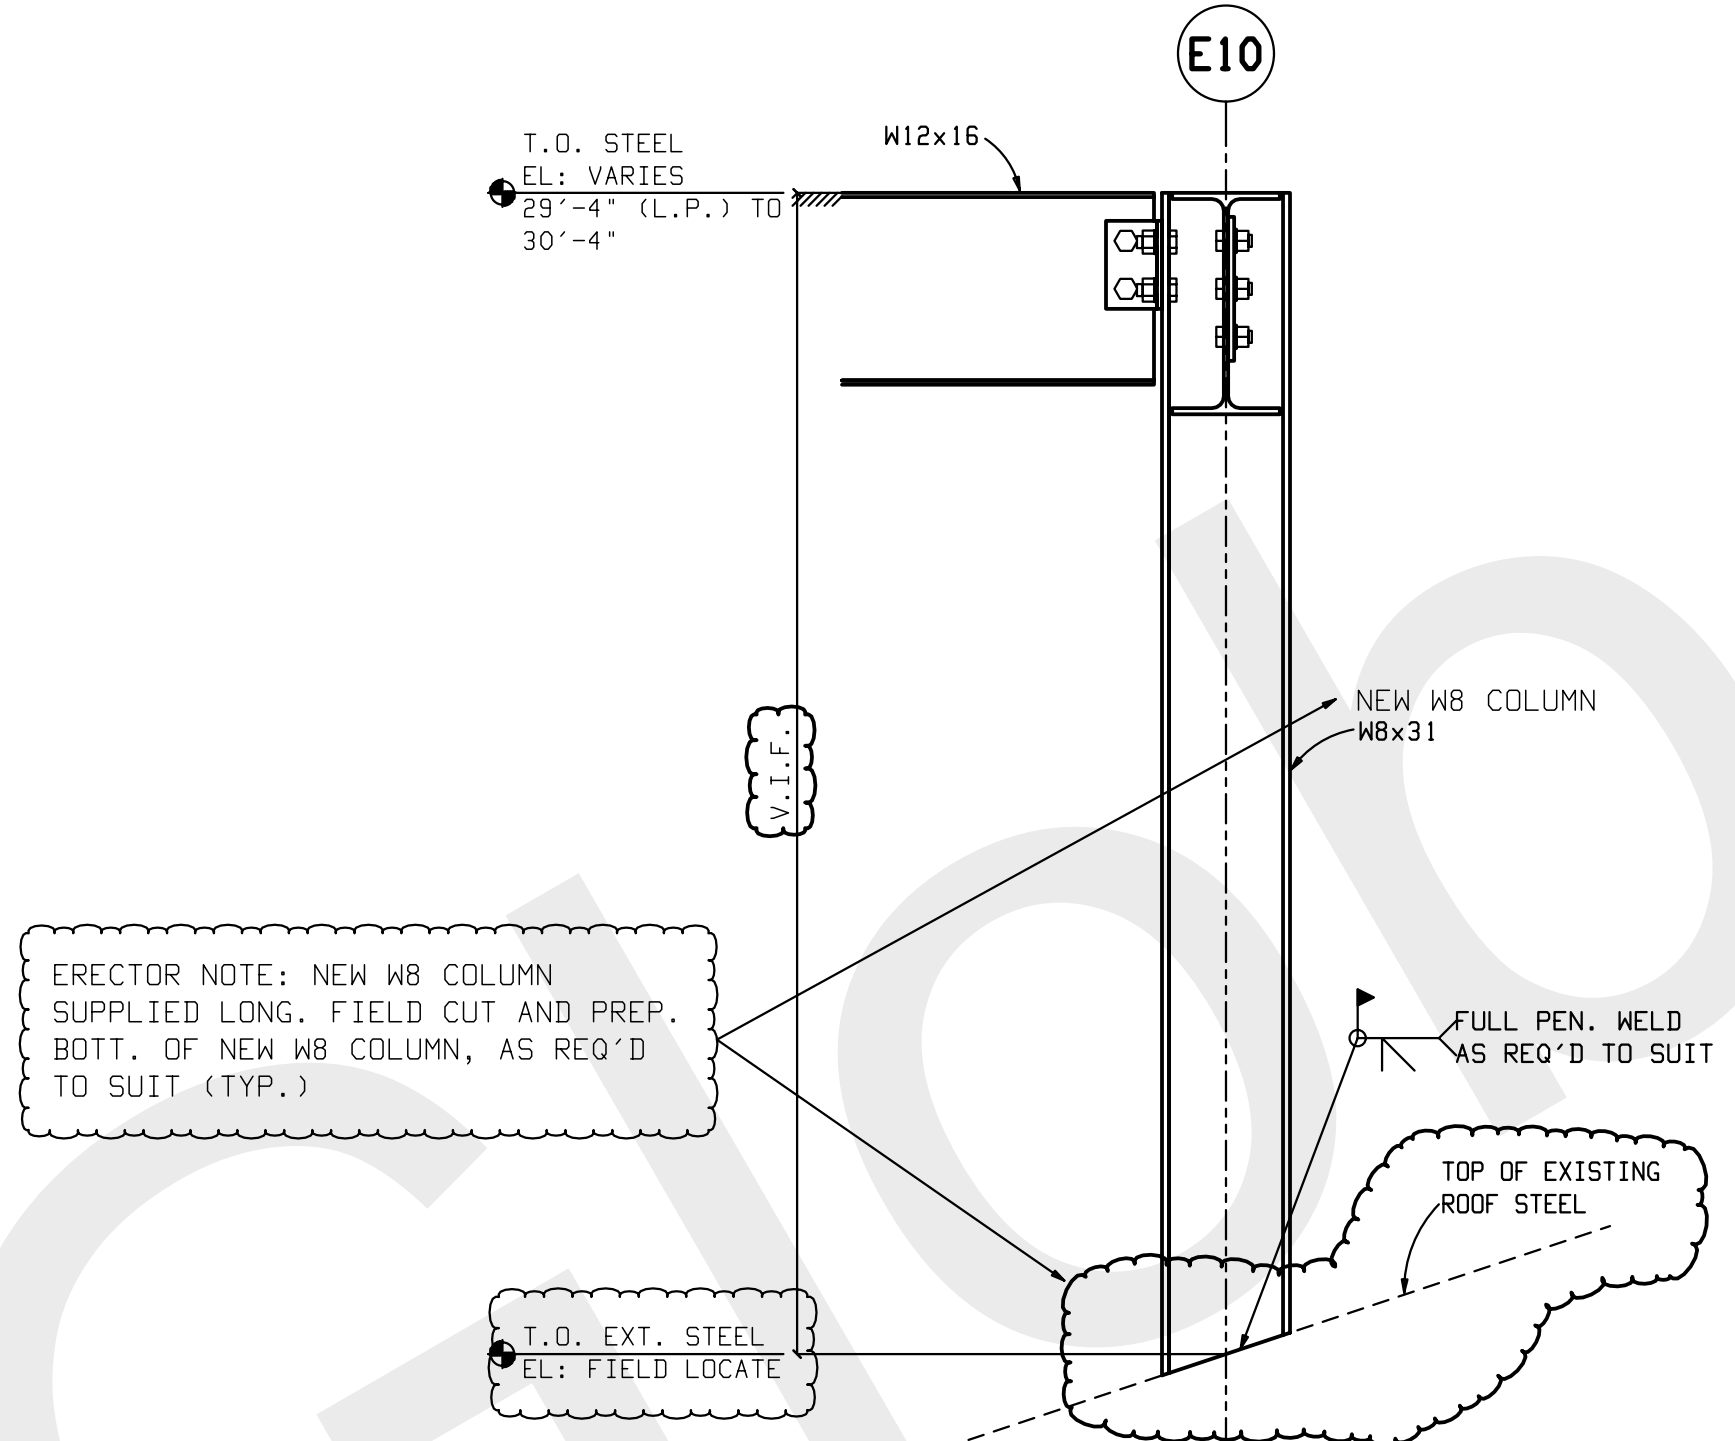

4 SECTION
E7 (REF: 9/SSO-01-01)

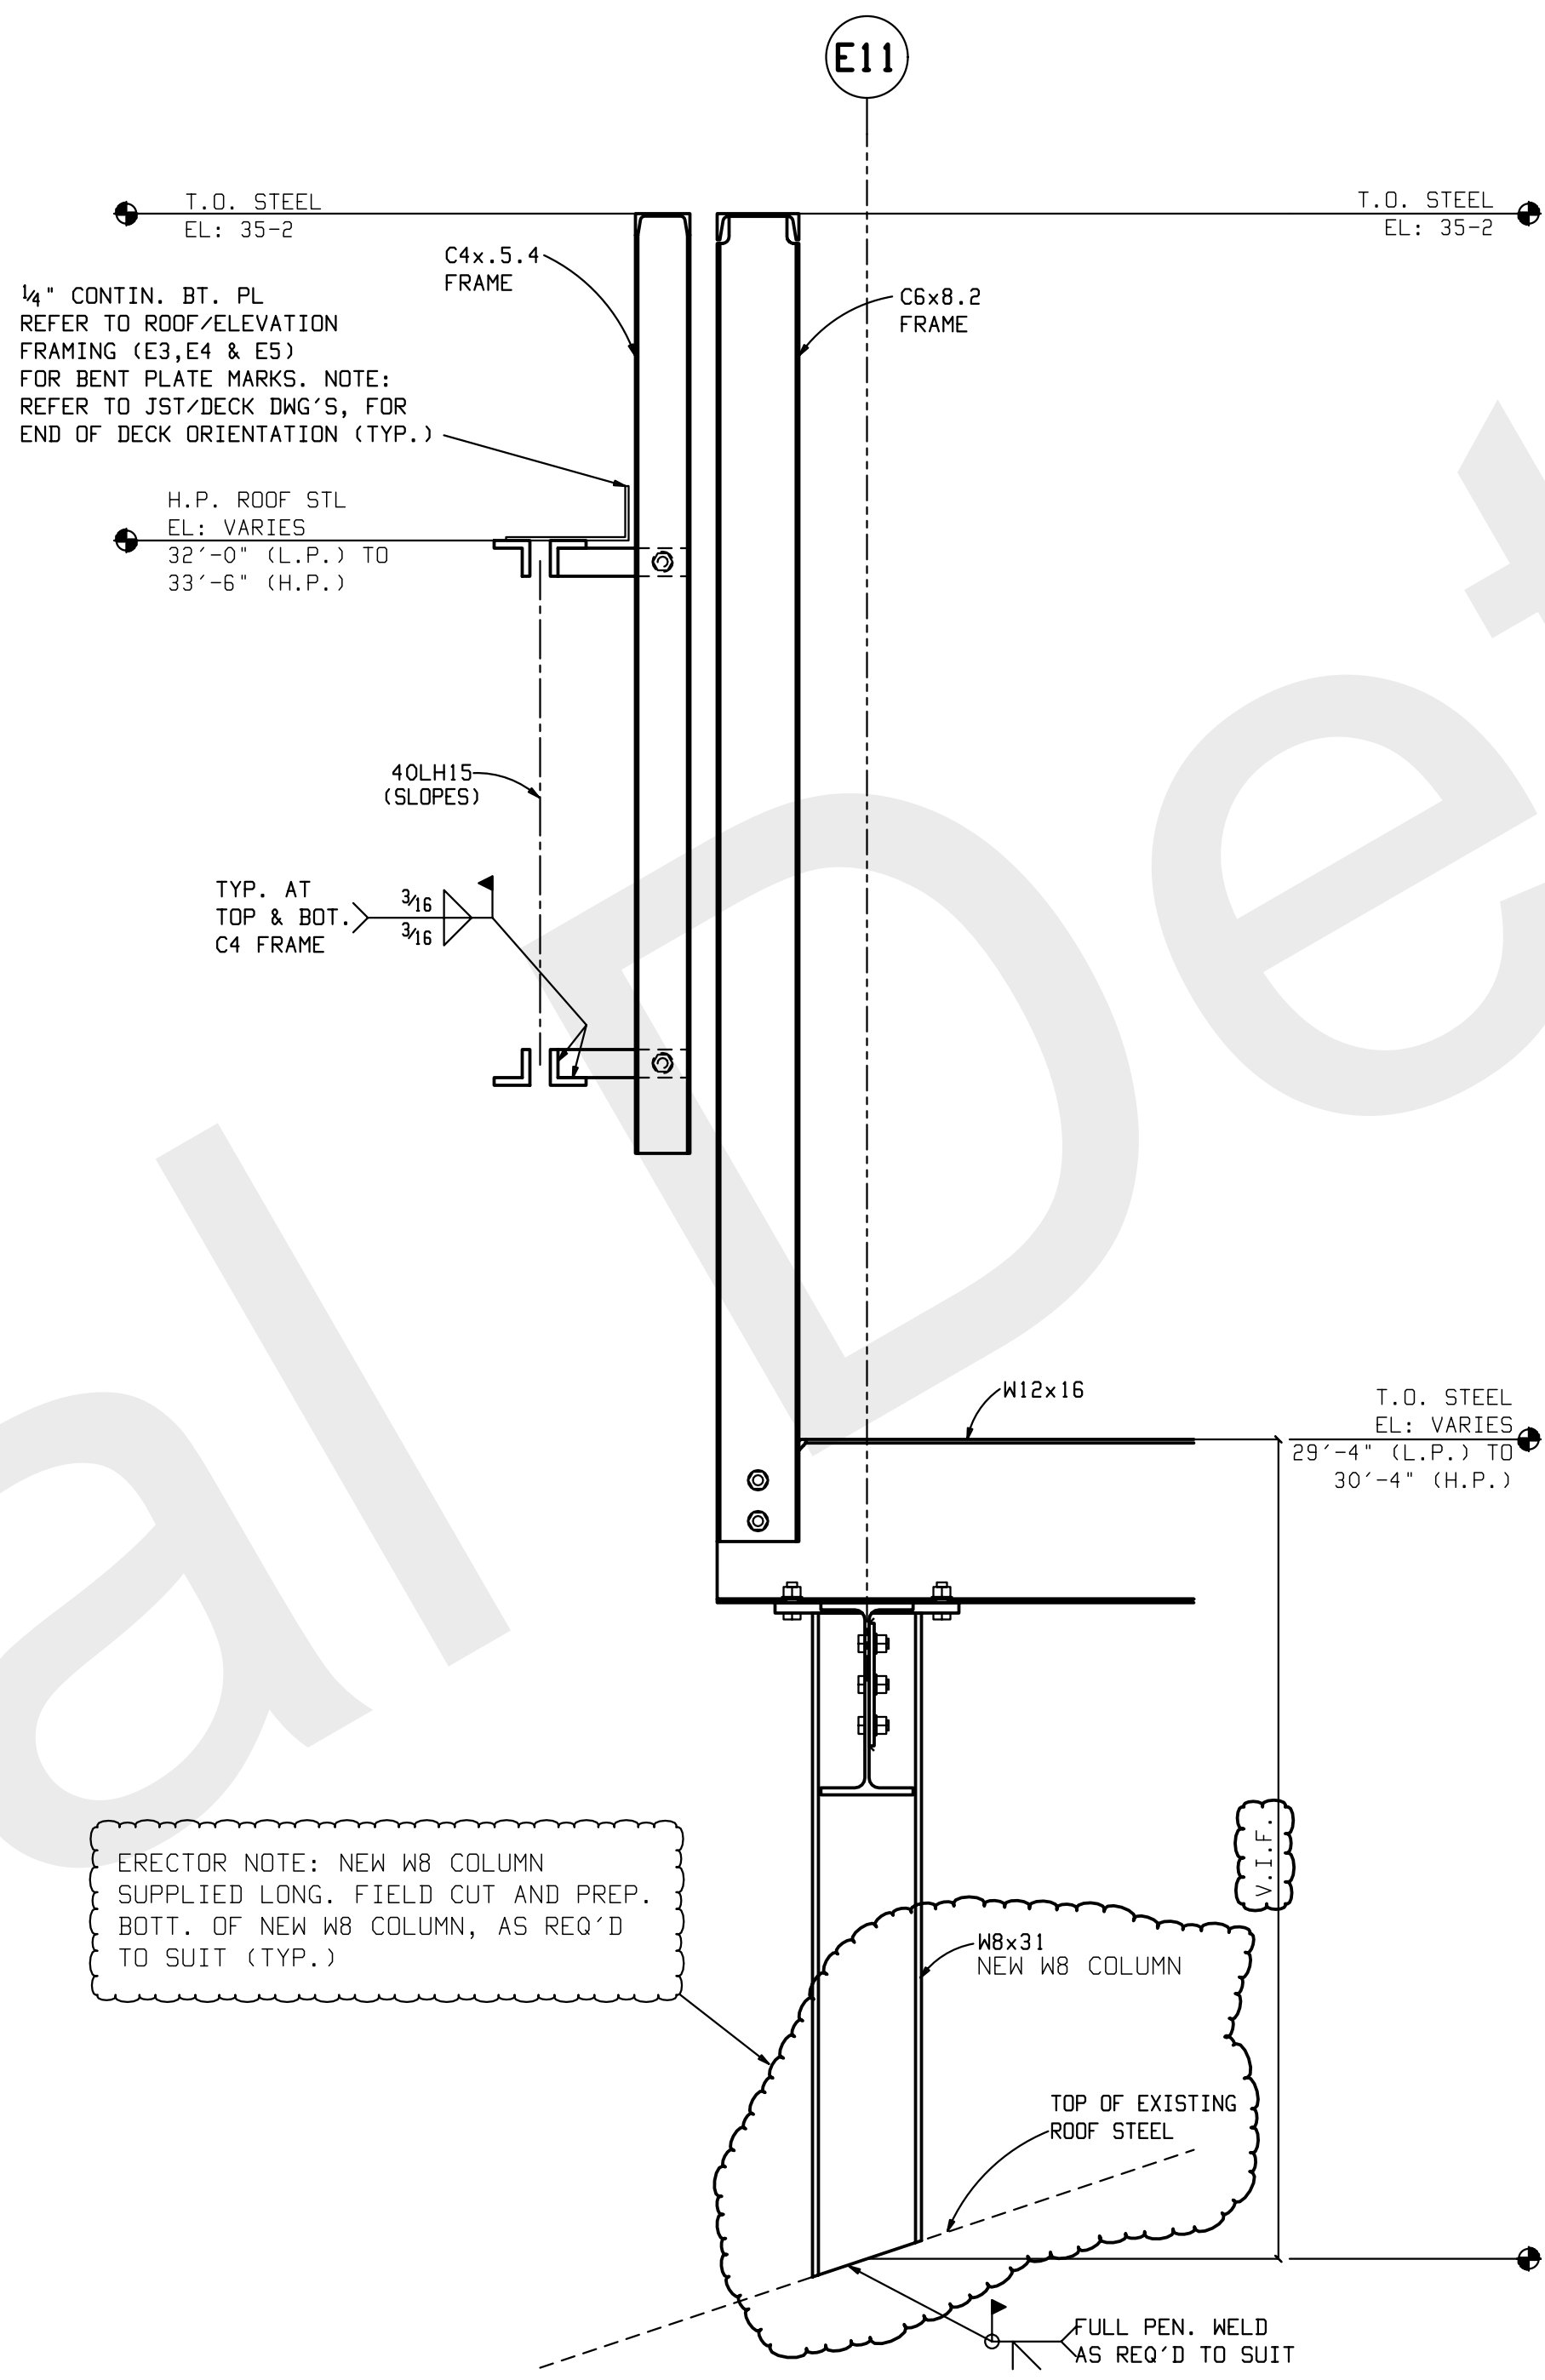

5 SECTION
E7 (REF: 8/SSO-01-01)






ALL VERIFIES, REQUEST FOR INFORMATION NOT RESPONDED TO AND/OR DIMENSIONS NOT FURNISHED WILL PLACE AFFECTED STEEL ON HOLD.

JEFFORDS STEEL AND ENGINEERING ASSUMES NO RESPONSIBILITY FOR ERRORS RESULTING FROM CONFLICTS IN CONTRACT DRAWINGS (ARCHITECTURAL/STRUCTURAL).

GENERAL NOTES:

CHARGES FOR CORRECTIVE WORK WILL NOT BE HONORED UNLESS PREVIOUS APPROVAL IS OBTAINED FROM JEFFORDS STEEL AND ENGINEERING COMPANY.

MEMBERS ARE TO BE ERECTED SO THAT MARKED END IS IN THE SAME LOCATION AS ON THE ERECTION DRAWING.

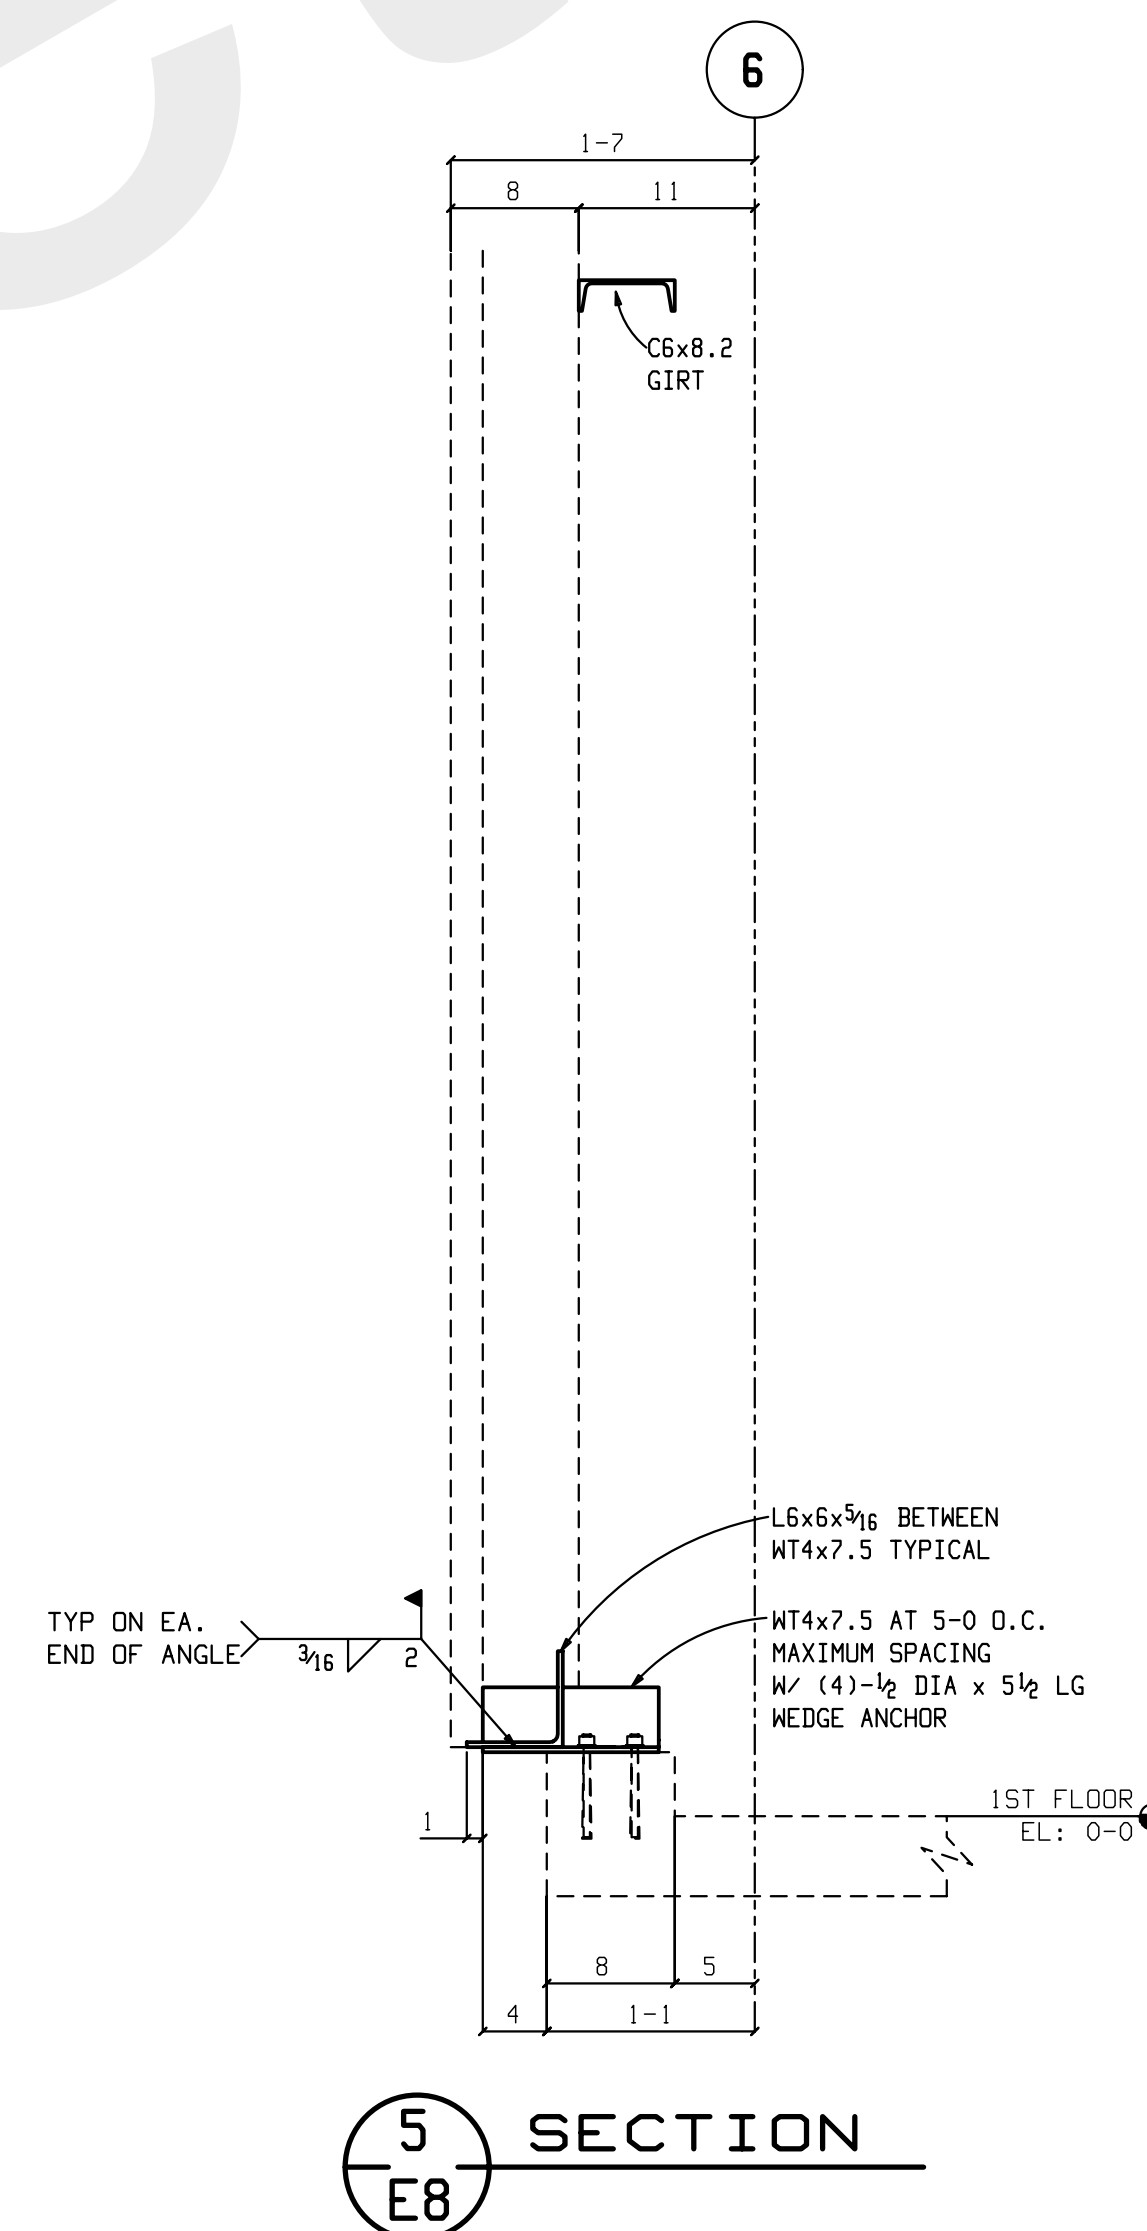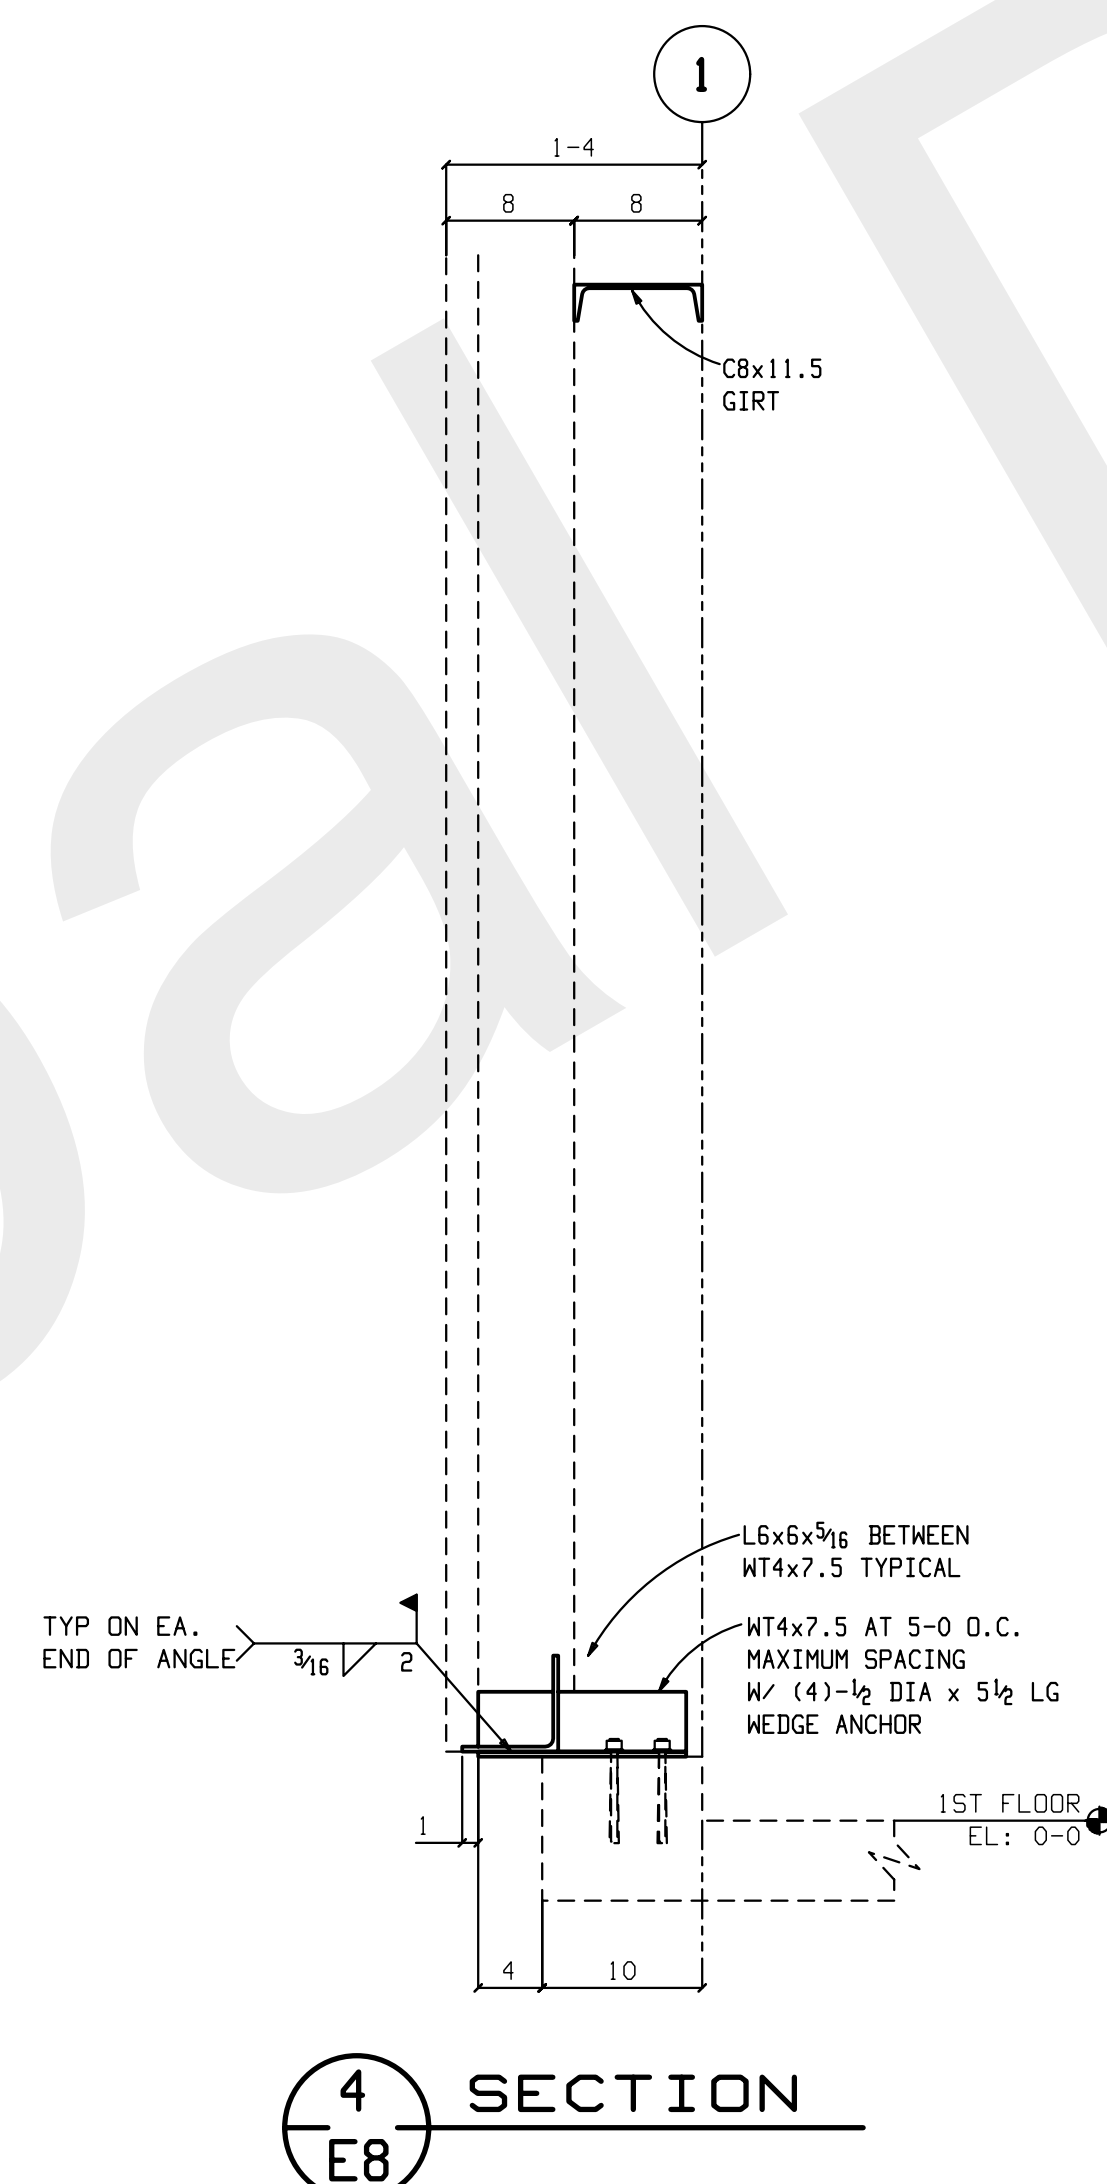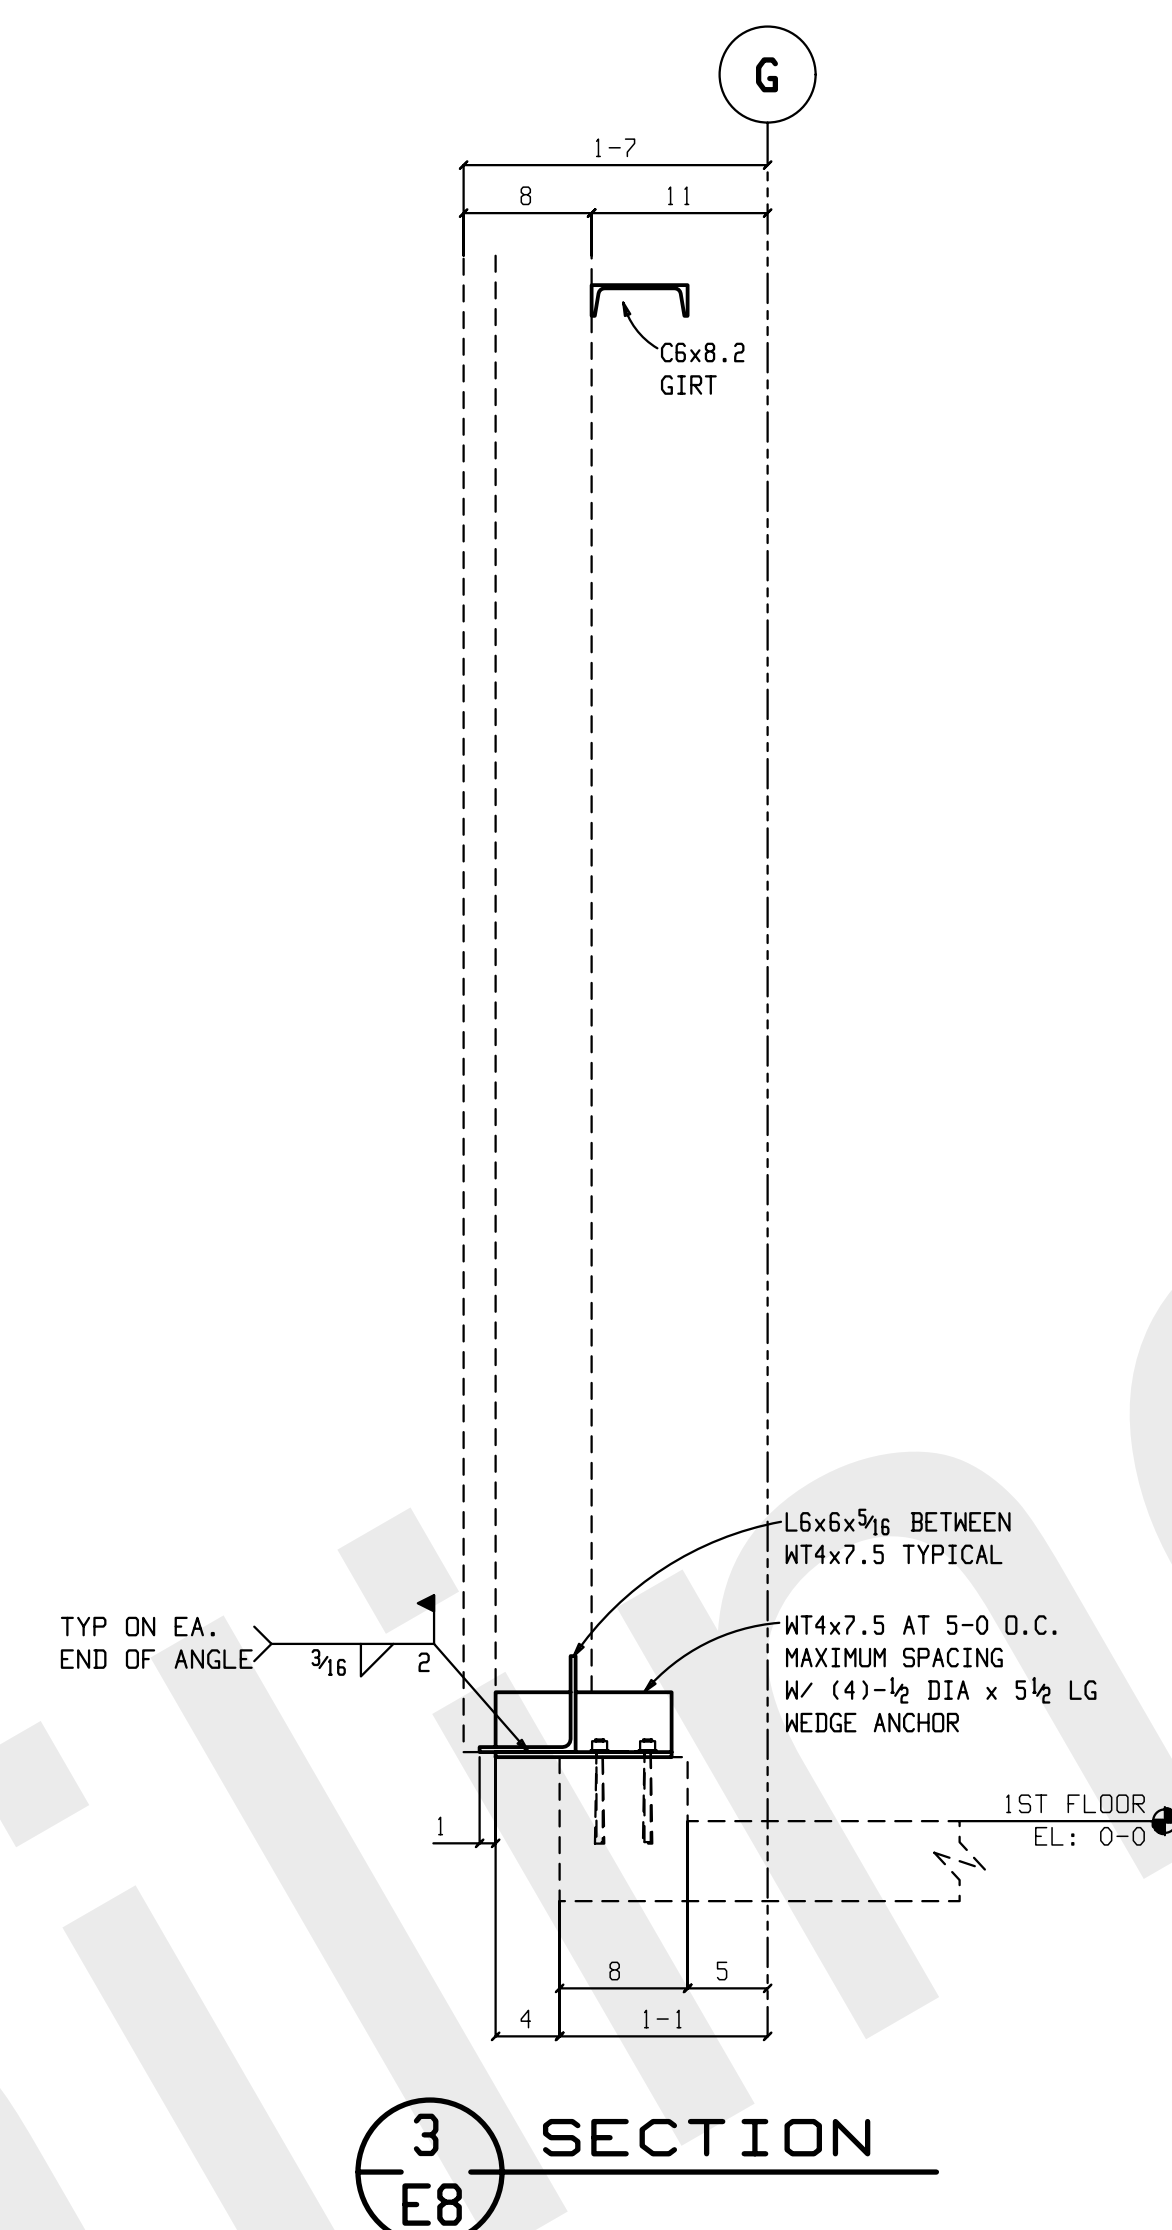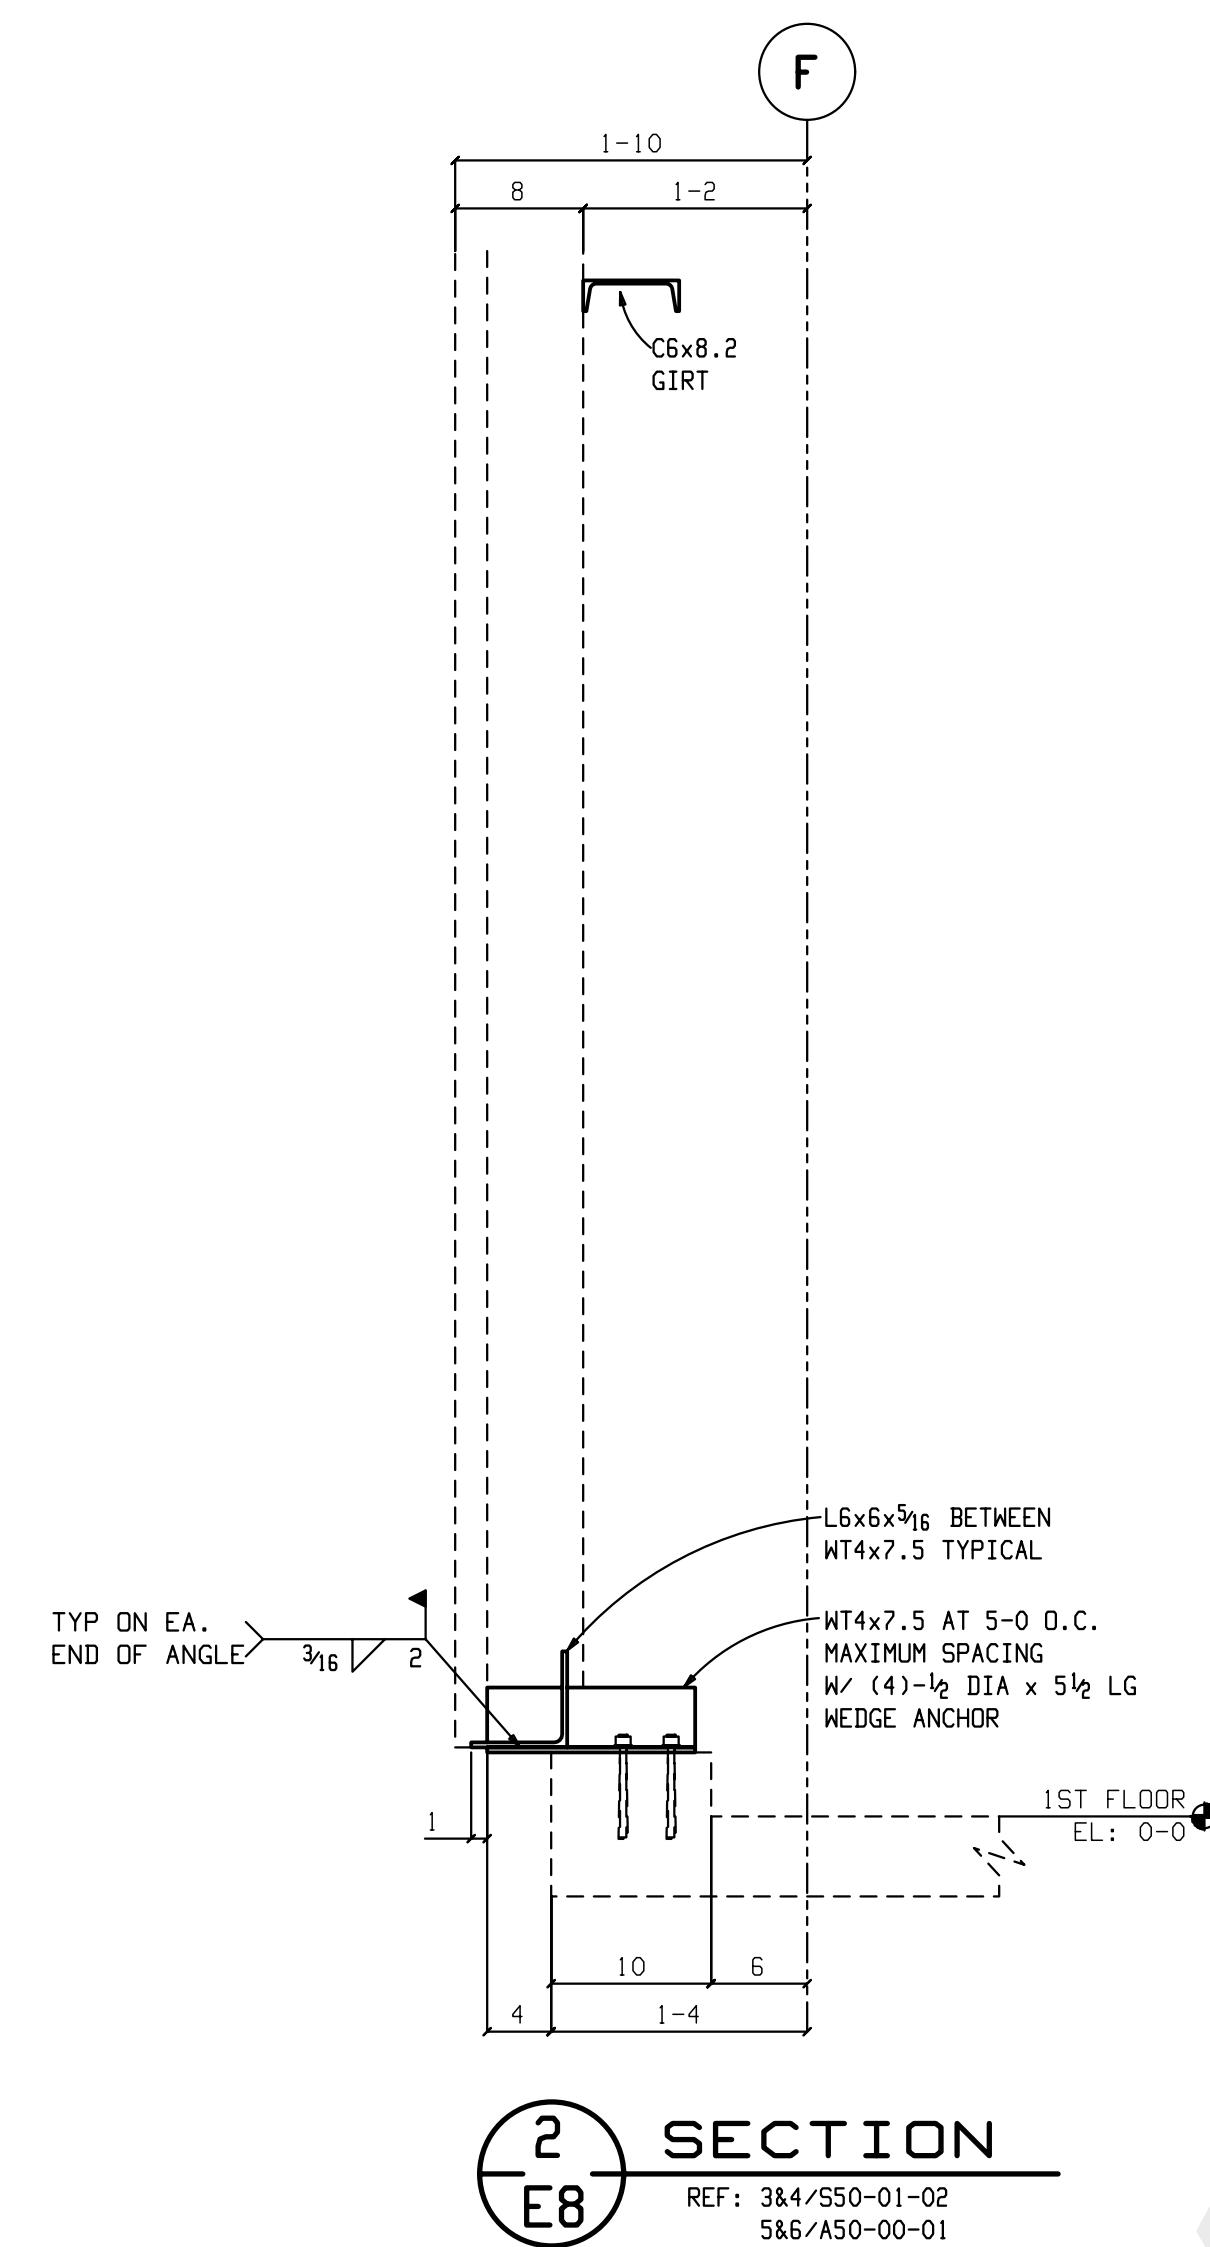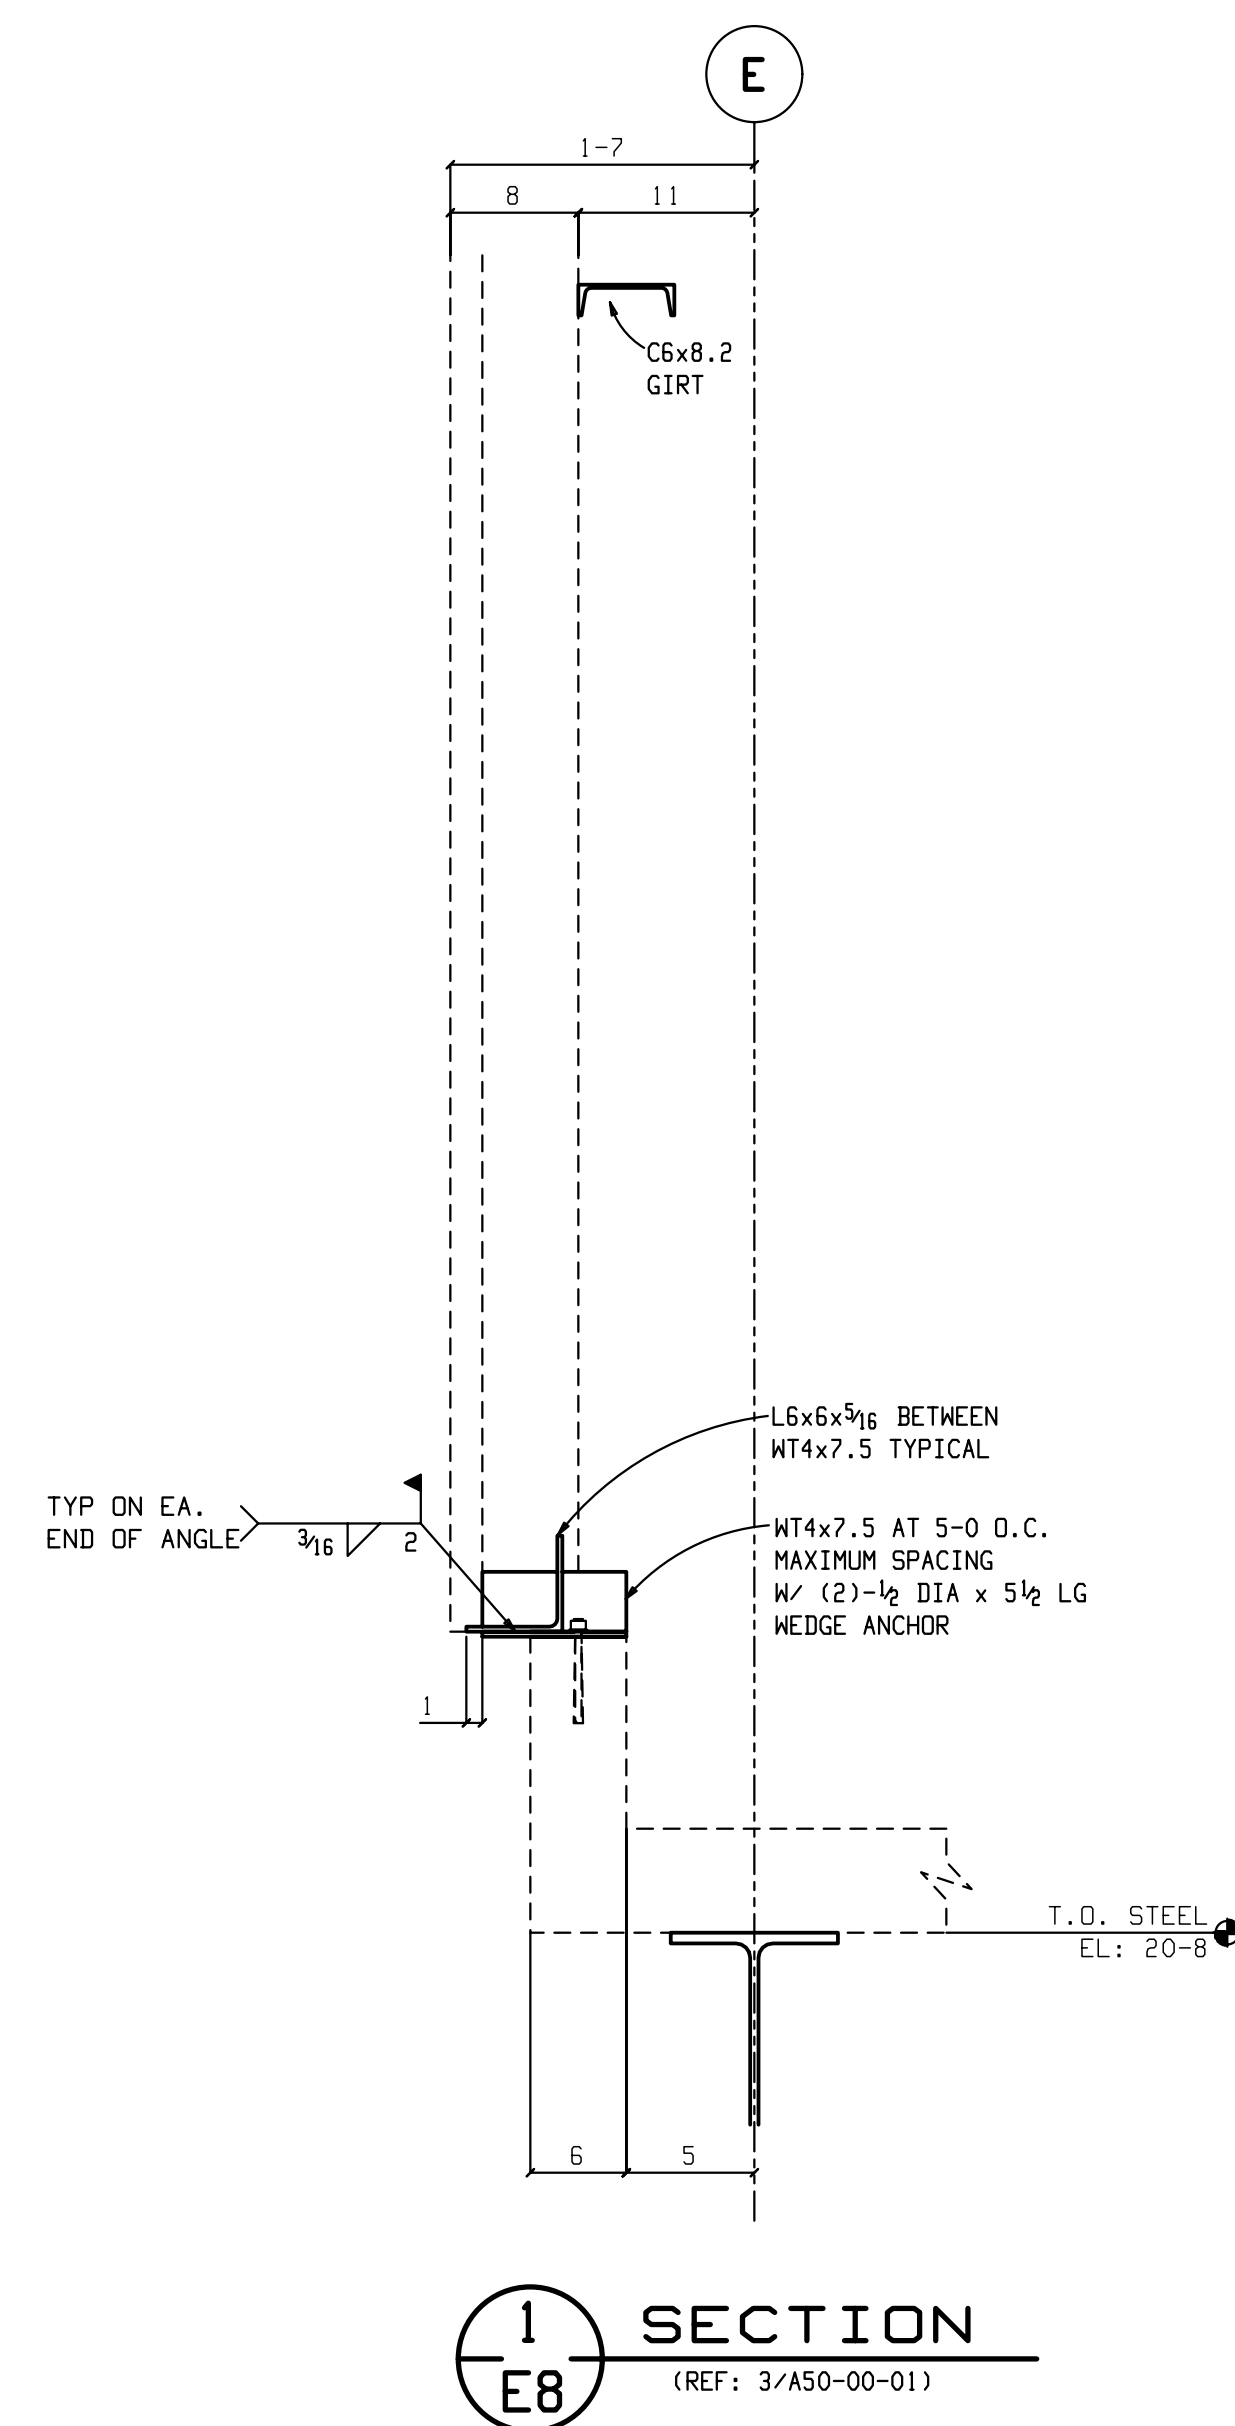

ALL VERIFIES, REQUEST FOR INFORMATION NOT
RESPONDED TO AND/OR DIMENSIONS NOT FURNISHED
WILL PLACE AFFECTED STEEL ON HOLD.

JEFFERDS STEEL AND ENGINEERING ASSUMES NO
RESPONSIBILITY FOR ERRORS RESULTING FROM
CONFLICTS IN CONTRACT DRAWINGS (ARCHITECTURAL/
STRUCTURAL).

GENERAL NOTES:

CHARGES FOR CORRECTIVE WORK WILL NOT BE HONORED UNLESS PREVIOUS APPROVAL IS OBTAINED FROM JEFFORDS STEEL AND ENGINEERING COMPANY.

MEMBERS ARE TO BE ERECTED SO THAT MARKED END IS IN THE SAME LOCATION AS ON THE ERECTION DRAWING.

ERECTIUM NORTH

1	APP	12-4
1	APP	1-6
1	FIELD	2-16

job no. 4497
date 1-4-12
drawn by MC
checked by - GDI

revisions	
rev#	date description




Jeffords
STEEL AND ENGINEERING COMPANY
P.O. BOX 40-4398 ROUTE #22
PLATTSBURGH, N. Y. 12901
518-561-4061

ENCOMPASS DEVELOP
DESIGN CONSTRUCTION

AKWESASNE MOHAWK CASINO
873 STATE HIGHWAY 37
AKWESASNE, NY

sheet

E8

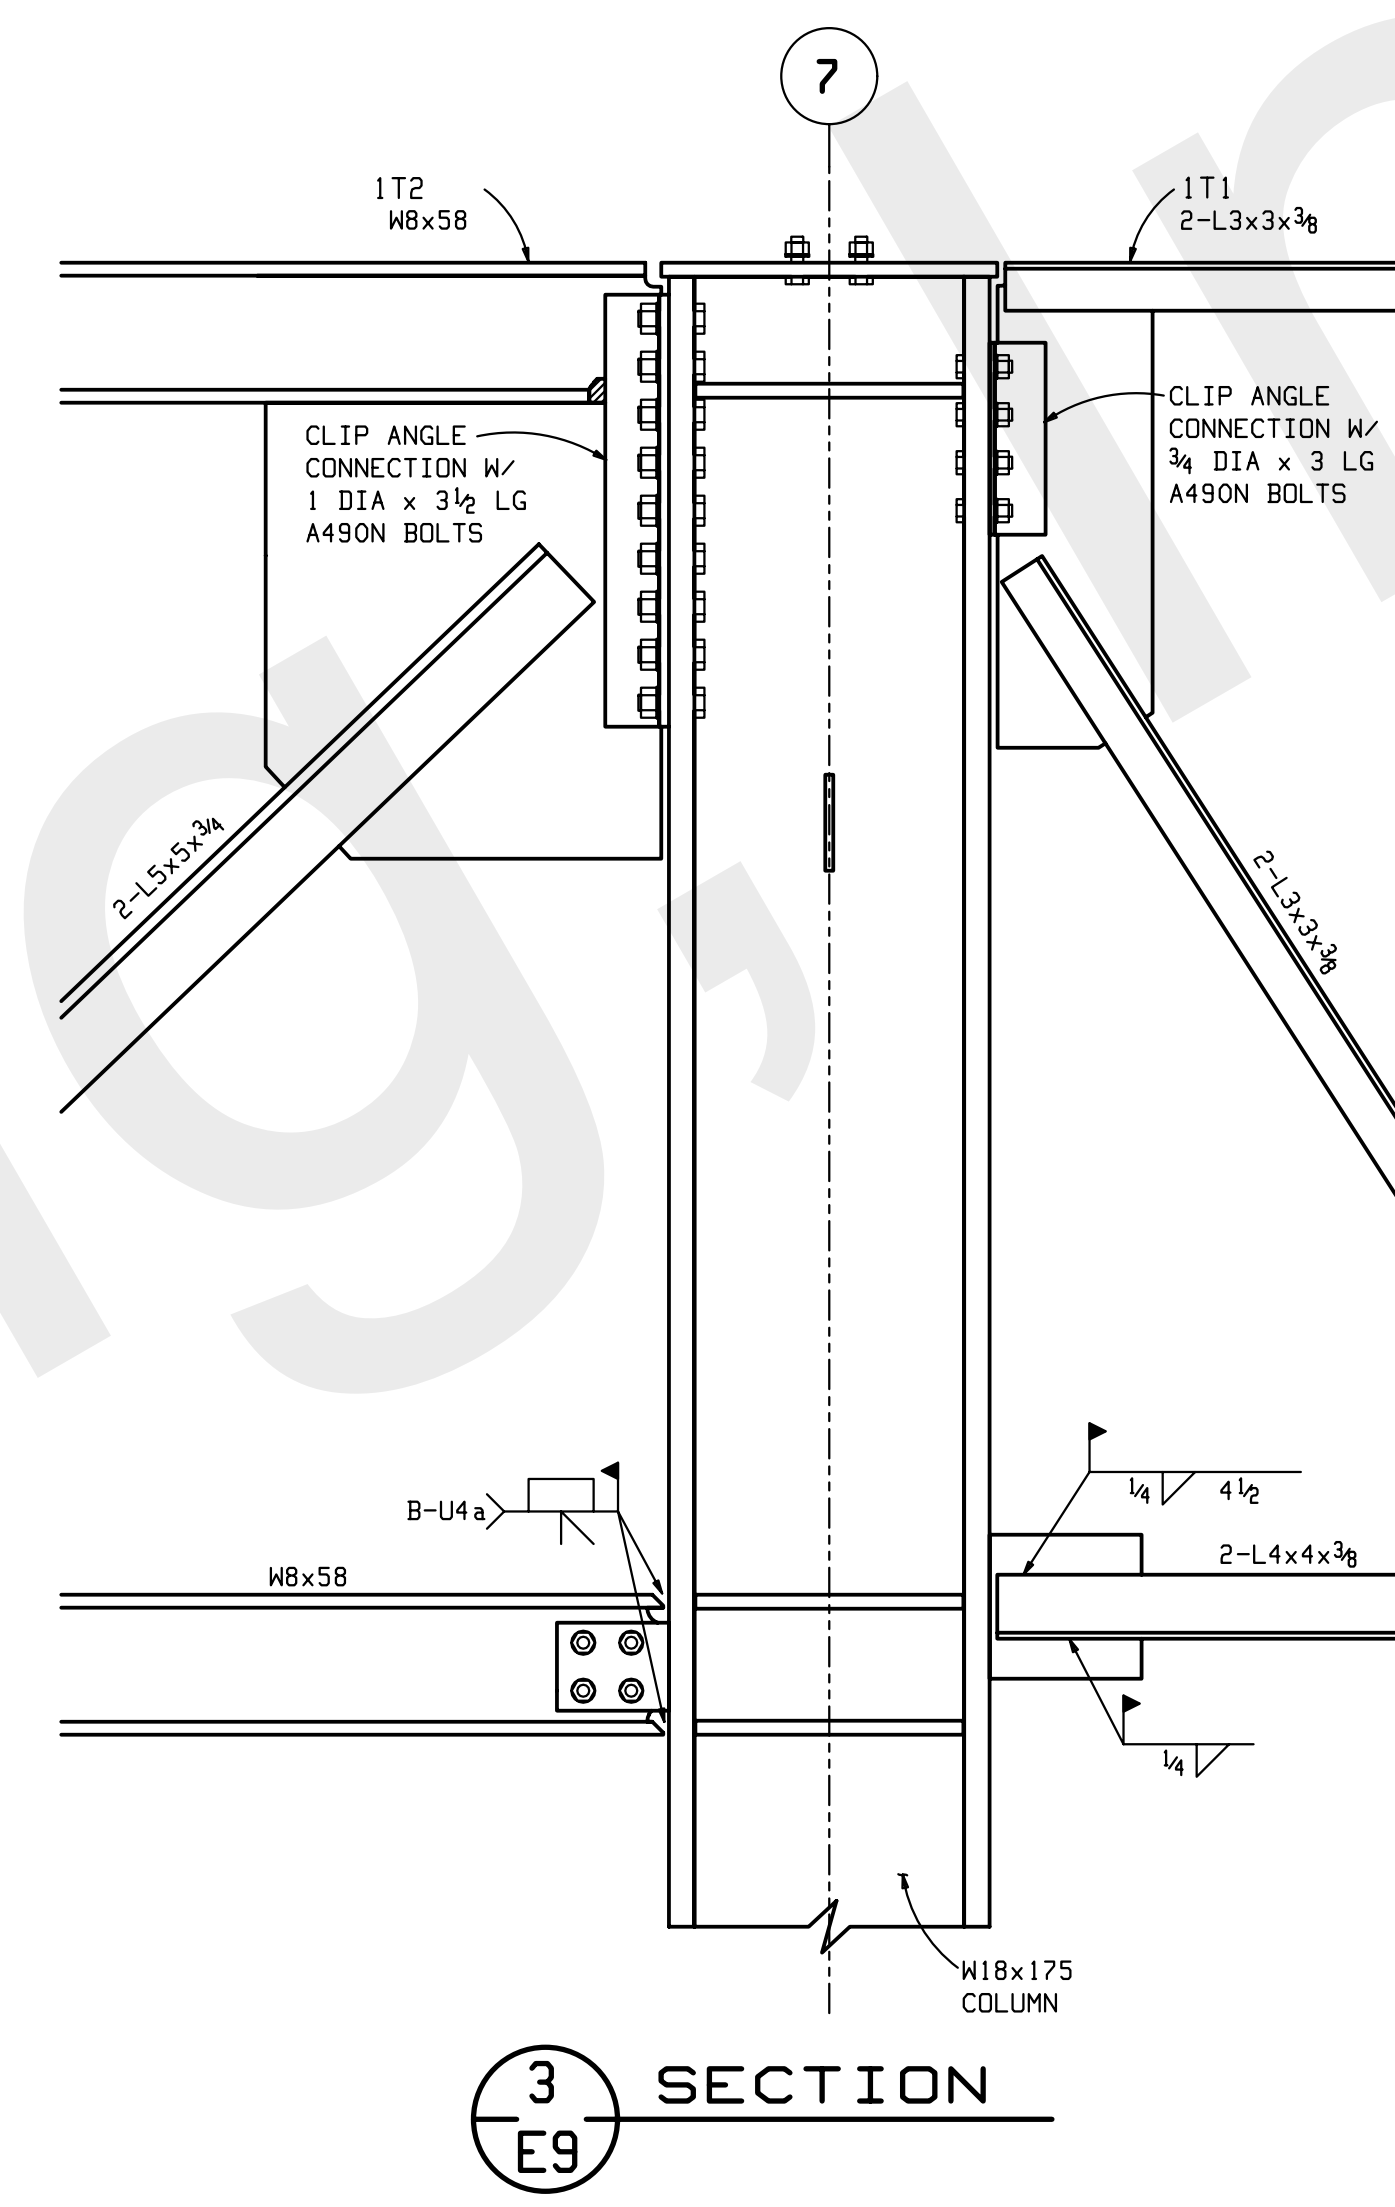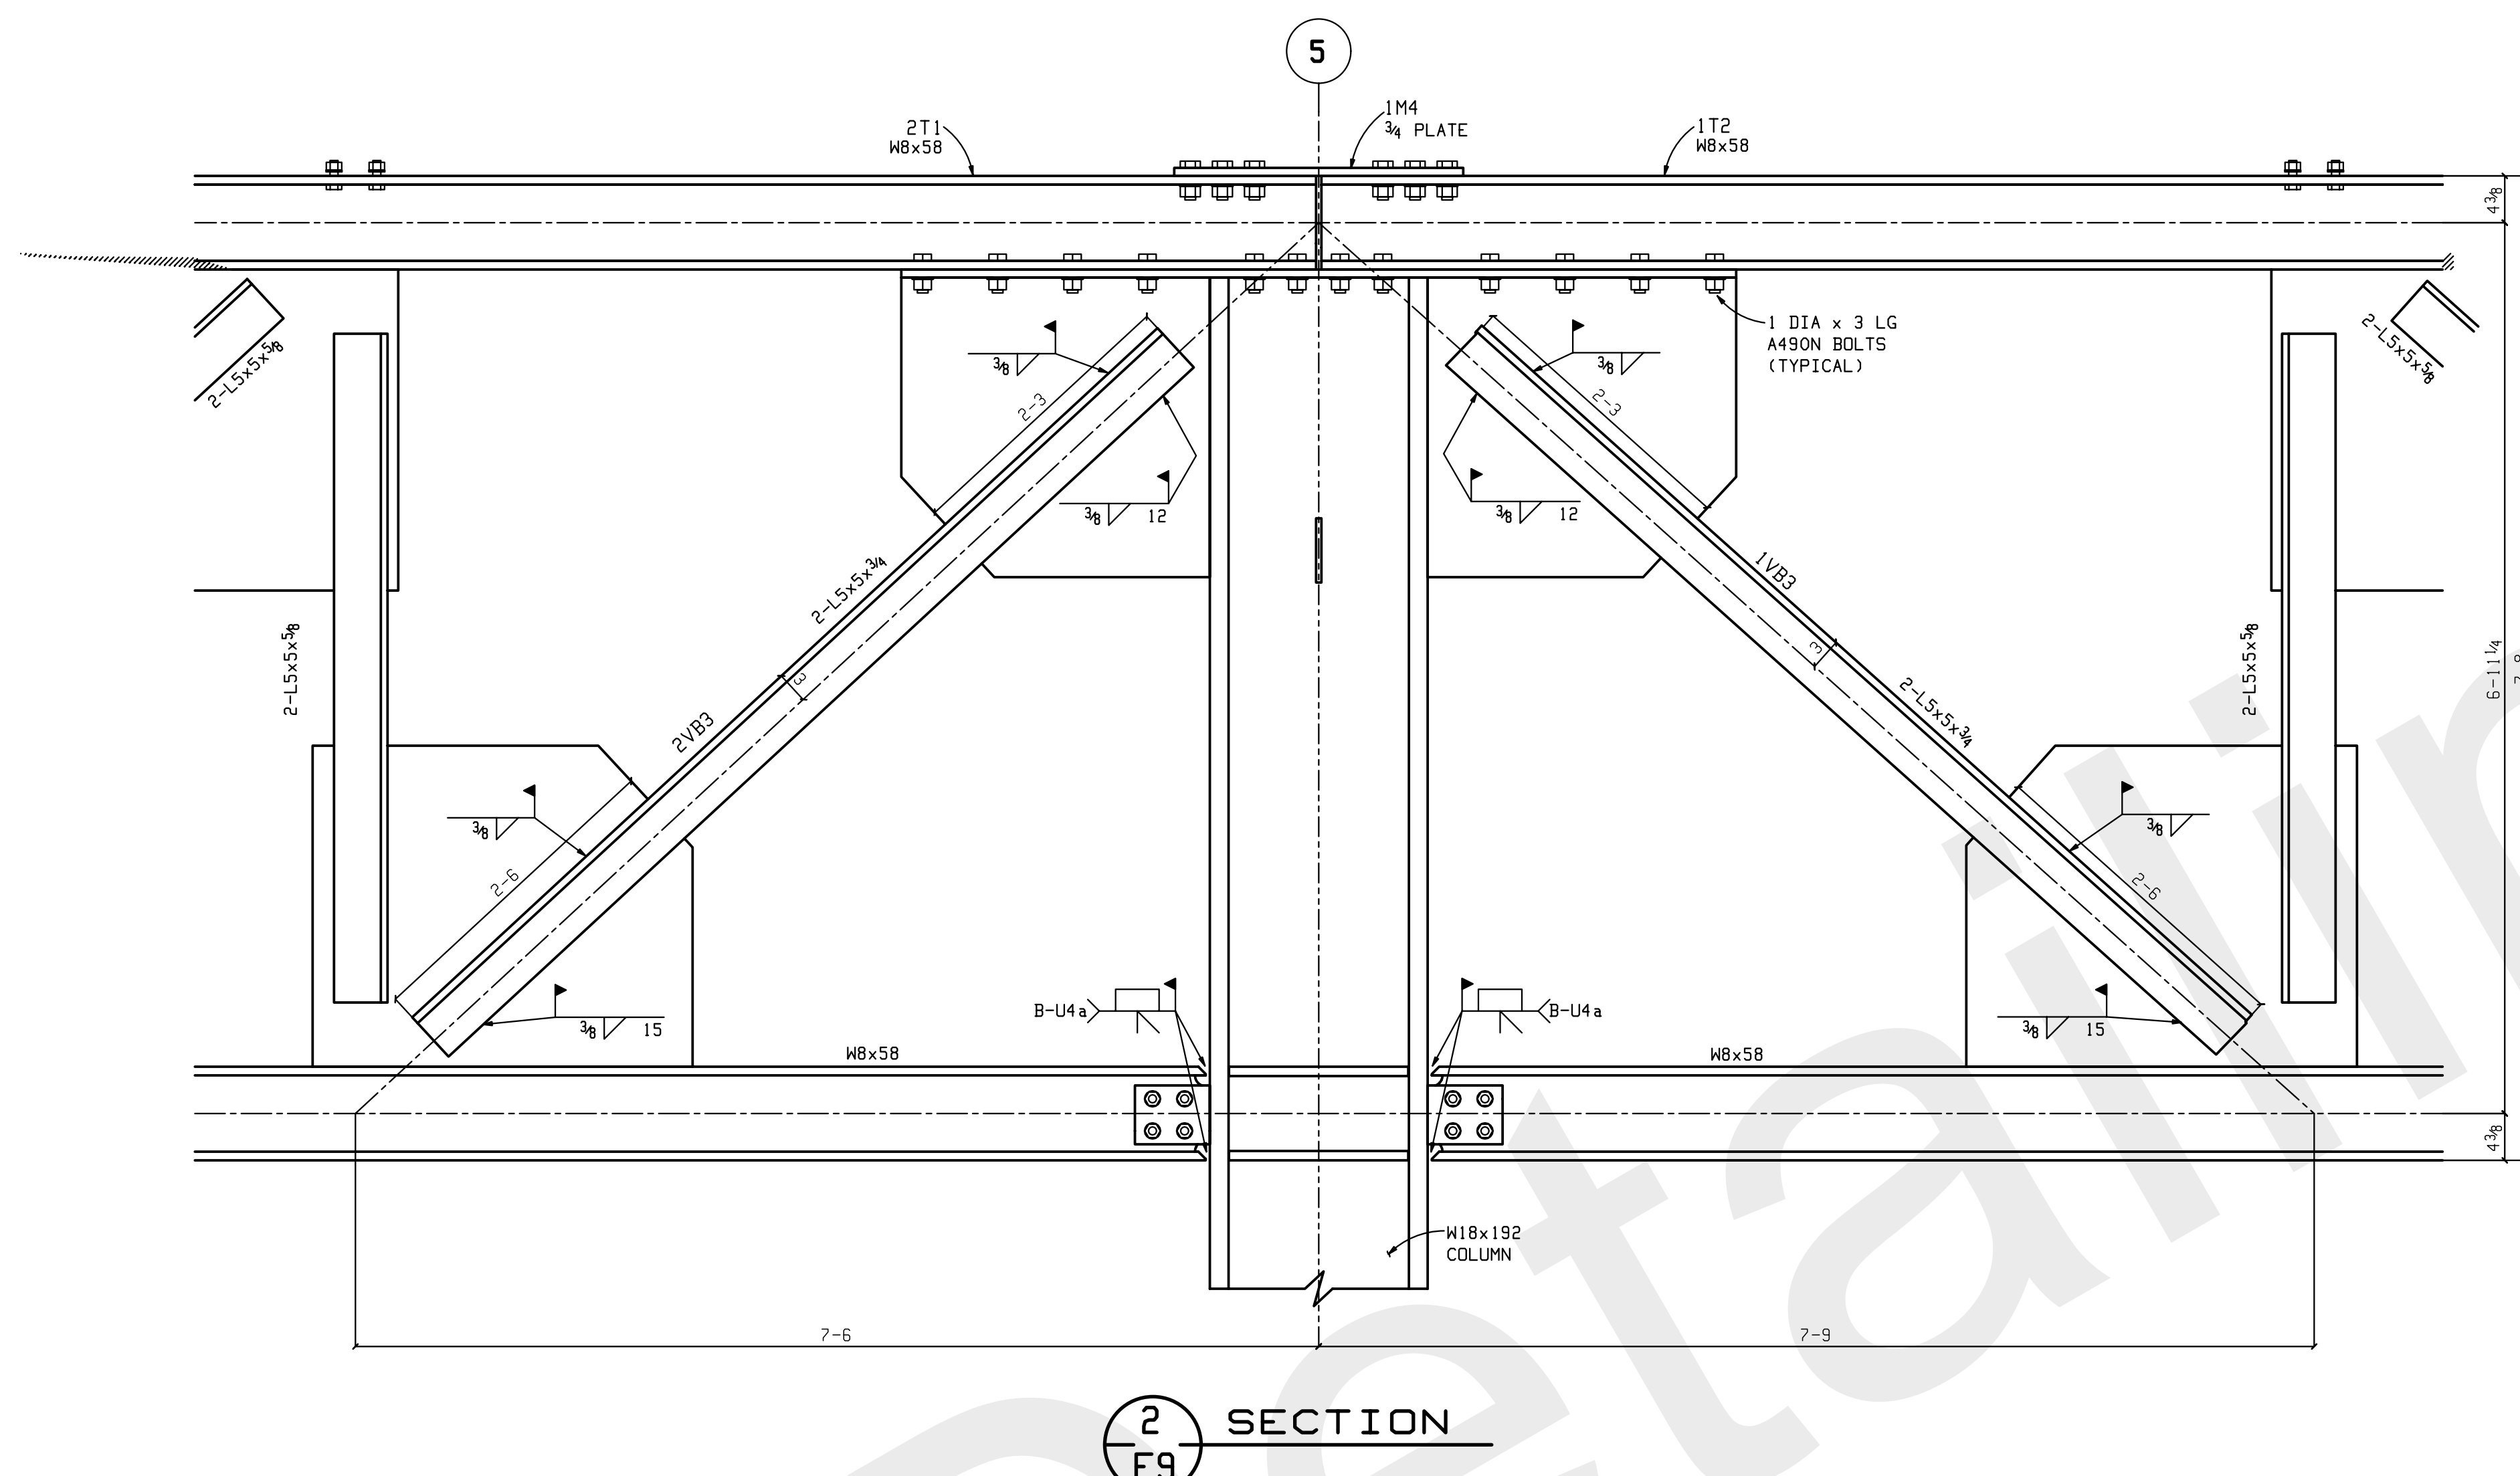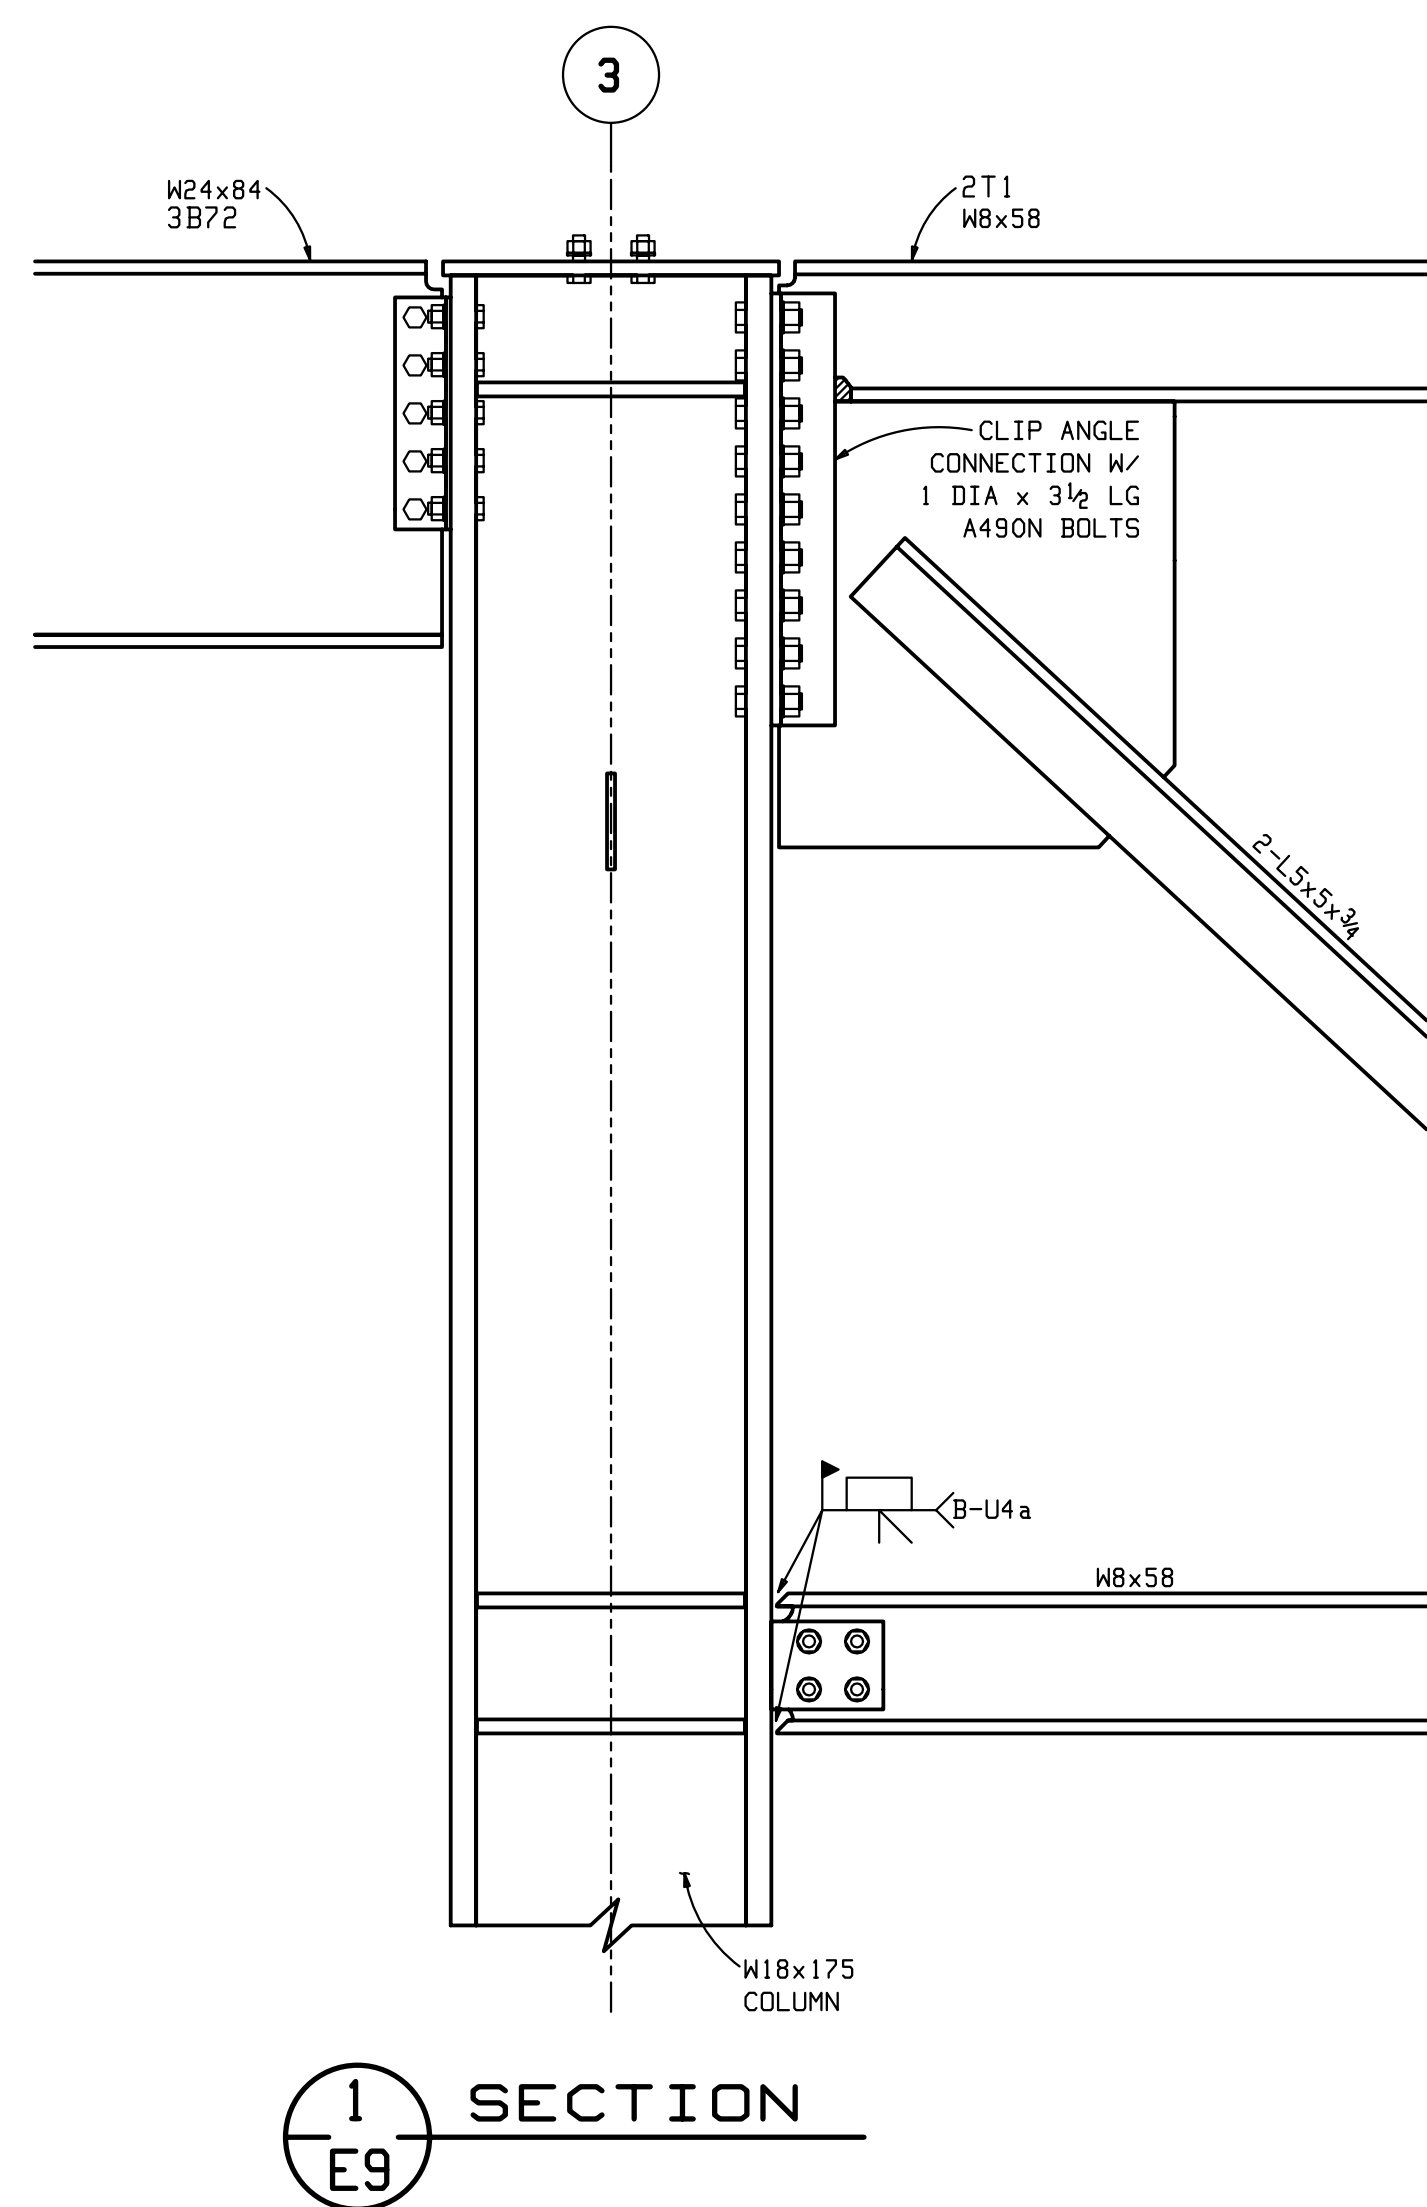

ERECTION NORTH

1	APP	12-4
1	APP	1-6
1	FIELD	2-16

job no. 4497
date 1-4-12
drawn by MC
checked by - CUI

revisions		
rev#	date	description

Jeffords
STEEL AND ENGINEERING COMPANY
P.O. BOX 40-4338 ROUTE #22
PLATTSBURGH, N.Y. 12501
518-561-1061

ENCOMPASS DEVELOP
DESIGN CONSTRUCTION

customer

AKWESASNE MOHAWK CASINO
873 STATE HIGHWAY 37
AKWESASNE, NY

project

sheet

E9


ALL VERIFIES, REQUEST FOR INFORMATION NOT
RESPONDED TO AND/OR DIMENSIONS NOT FURNISHED
WILL PLACE AFFECTED STEEL ON HOLD.

JEFFORDS STEEL AND ENGINEERING ASSUMES NO
RESPONSIBILITY FOR ERRORS RESULTING FROM
CONFLICTS IN CONTRACT DRAWINGS (ARCHITECTURAL
STRUCTURAL).

GENERAL NOTES:

CHARGES FOR CORRECTIVE WORK WILL NOT BE HONORED UNLESS
PREVIOUS APPROVAL IS OBTAINED FROM JEFFORDS STEEL AND
ENGINEERING COMPANY.

MEMBERS ARE TO BE ERECTED SO THAT MARKED END IS IN THE SAME LOCATION AS ON THE ERECTION DRAWING.

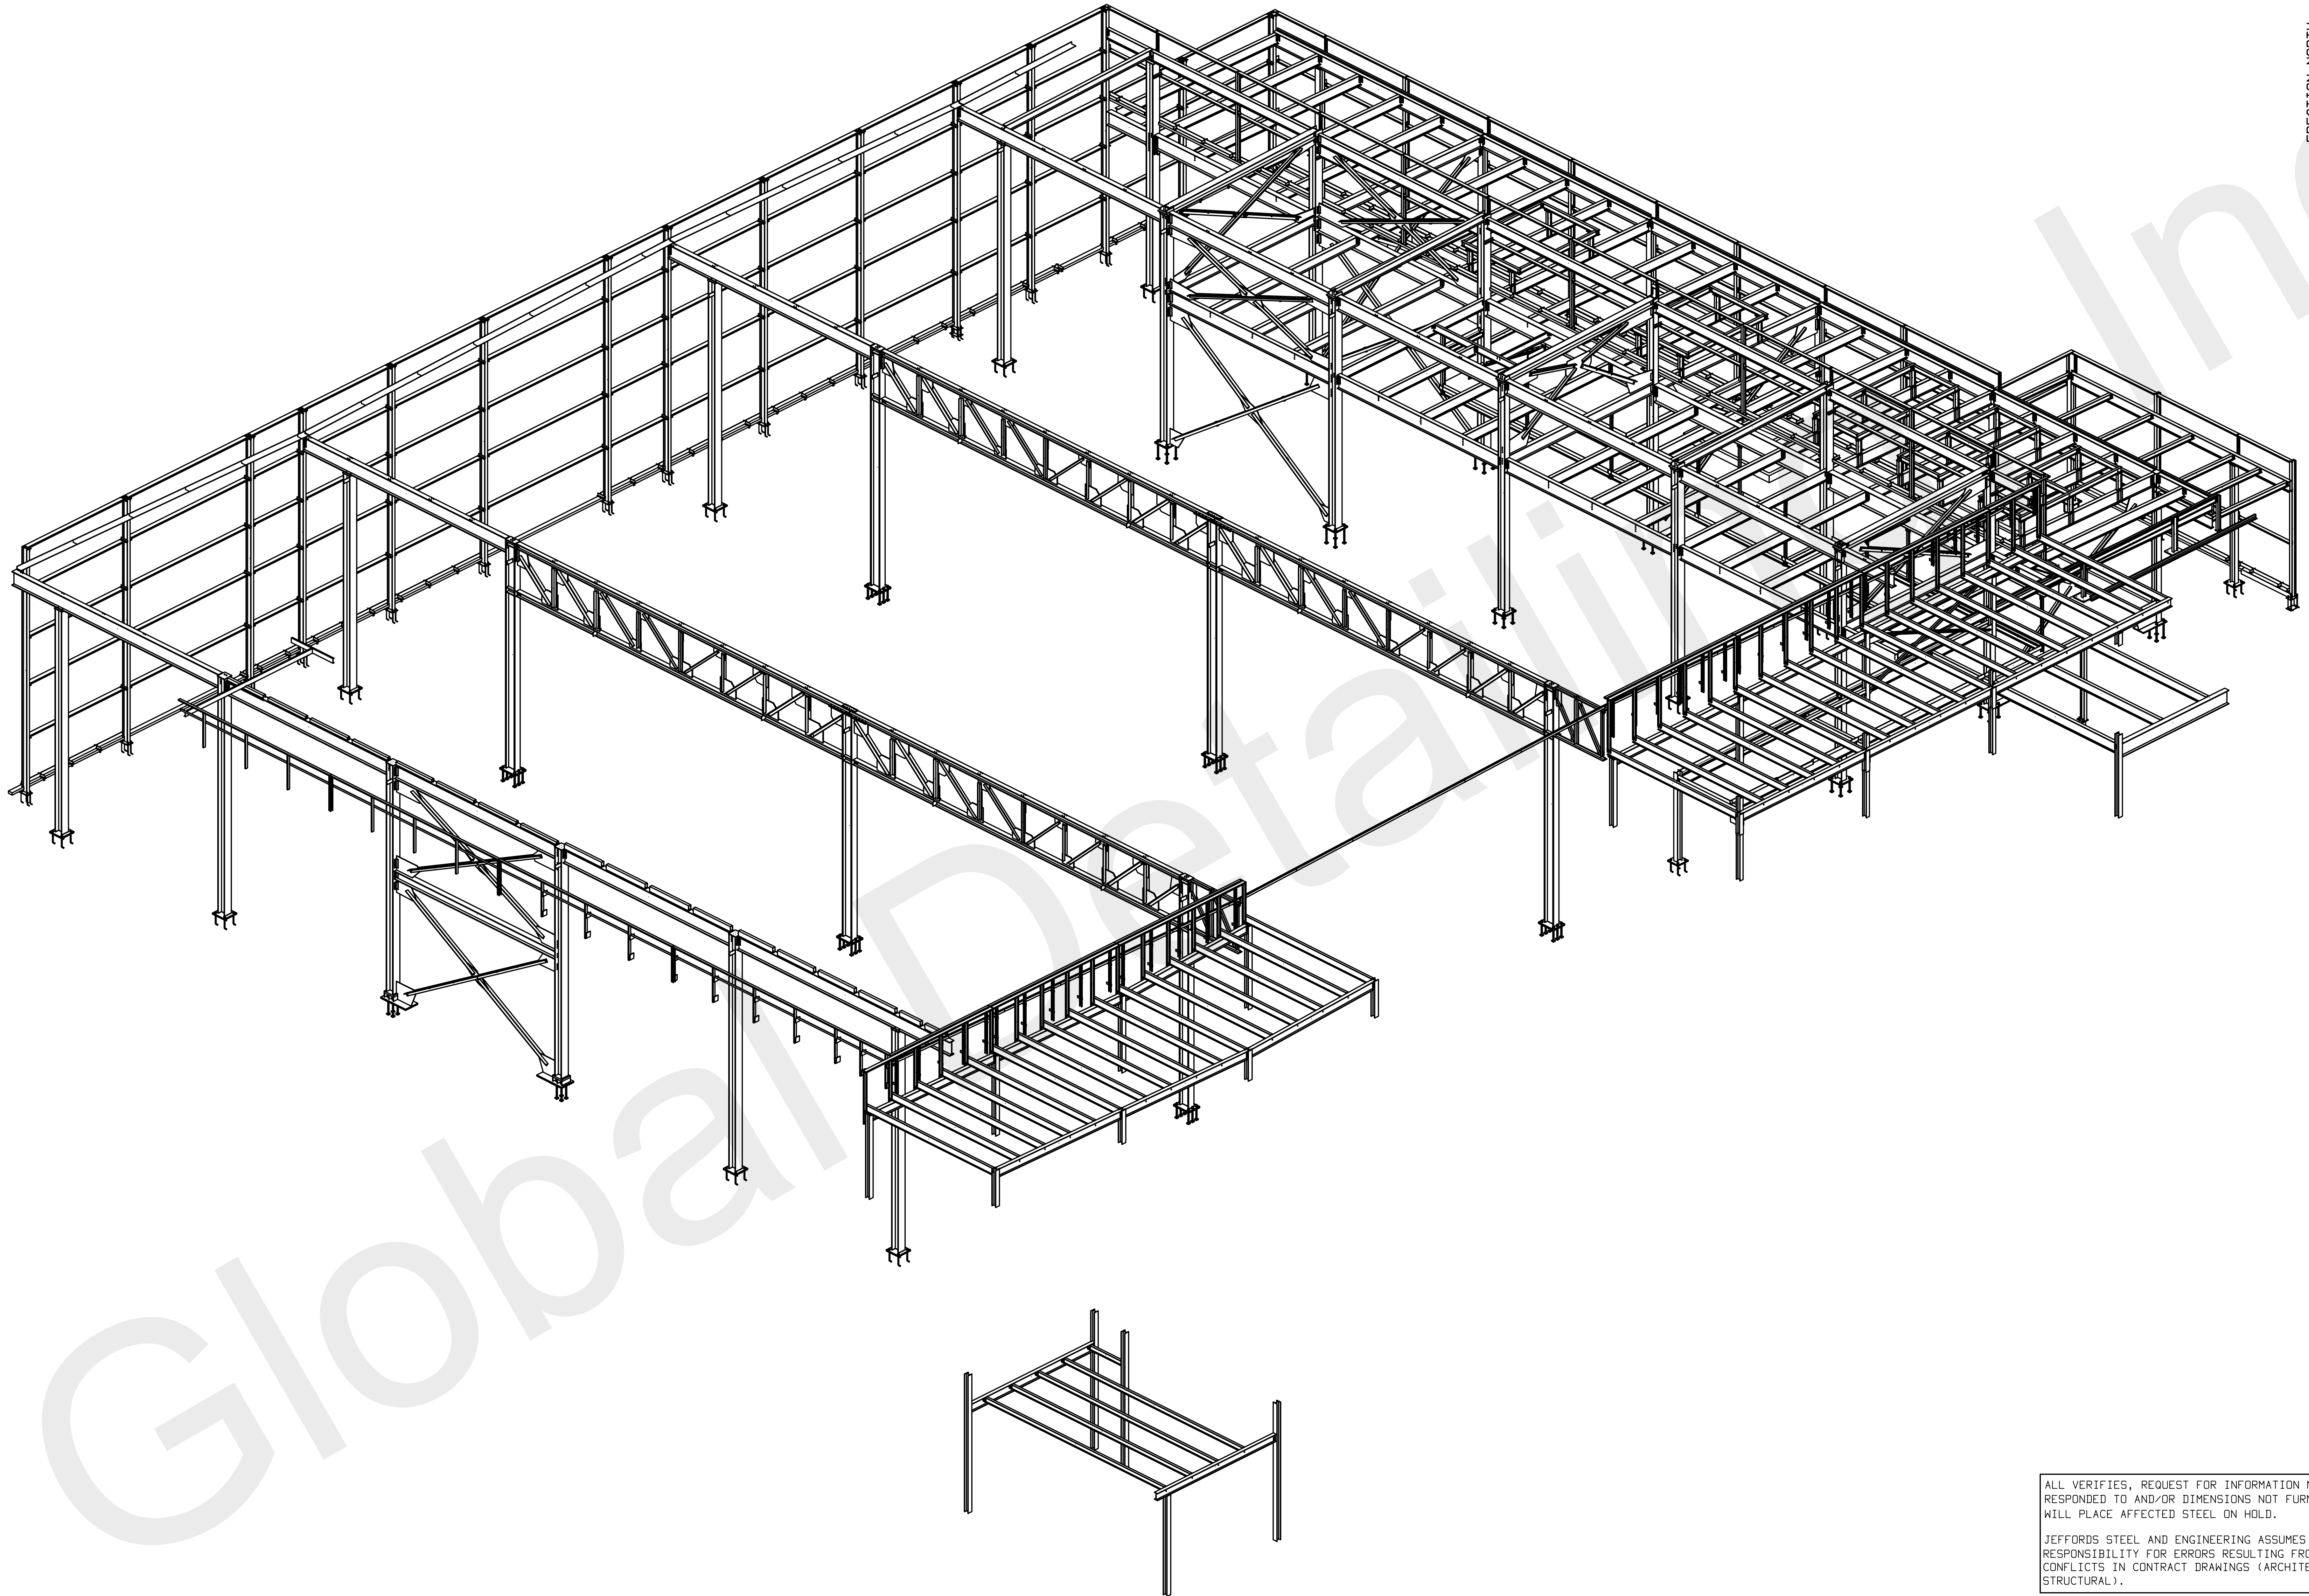

ERECTION NORTH

print record			
1	APP	12-4	
1	APP	1-6	

job no. 487	date 1-4-12	drawn by MC	checked by -
-------------	-------------	-------------	--------------

revisions		description	
rev#	date		

JEFFORDS

STEEL AND ENGINEERING COMPANY
P.O. BOX 488 PRINCE GEORGE
PITTSBURGH, N.Y. 15201
518-561-4061

CUSTOMER
ENCOMPASS DEVELOPMENT
DESIGN CONSTRUCTION

PROJECT
AKWESASNE MOHAWK CASINO
873 STATE HIGHWAY 37
AKWESASNE, NY

SHEET
IS01

ALL VERIFIES, REQUEST FOR INFORMATION NOT RESPONDED TO AND/OR DIMENSIONS NOT FURNISHED WILL PLACE AFFECTED STEEL ON HOLD.
JEFFORDS STEEL AND ENGINEERING ASSUMES NO RESPONSIBILITY FOR ERRORS RESULTING FROM CONFLICTS IN CONTRACT DRAWINGS (ARCHITECTURAL/STRUCTURAL).

GENERAL NOTES:
CHARGES FOR CORRECTIVE WORK WILL NOT BE HONORED UNLESS PREVIOUS APPROVAL IS OBTAINED FROM JEFFORDS STEEL AND ENGINEERING COMPANY.
MEMBERS ARE TO BE ERECTED SO THAT MARKED END IS IN THE SAME LOCATION AS ON THE ERECTION DRAWING.



HE

1M17

11M4
(SEE PLAN
FOR PC MK)

TC-U4a

1B62

EL. 22-2

W27x129

11VB1

11VB2

2-L3x3x1/4

2-L3x3x1/4

7'-3"

11B81

B-U4b

B-U4b

W12x40

EL. 14-4316

W12x40
11B77

FIELD WELD FLANGES FIRST,
REMOVE CHANNELS THEN WELD
WEB OF COLUMN

ALL VERIFIES, REQUEST FOR INFORMATION NOT
RESPONDED TO AND/OR DIMENSIONS NOT FURNISHED
WILL PLACE AFFECTED STEEL ON HOLD.

JEFFORDS STEEL AND ENGINEERING ASSUMES NO
RESPONSIBILITY FOR ERRORS RESULTING FROM
CONFLICTS IN CONTRACT DRAWINGS (ARCHITECTURAL/
STRUCTURAL).

SECTION

2
E1

FIELD WELD FLANGES FIRST,
REMOVE CHANNELS THEN WELD
WEB OF COLUMN

ALL VERIFIES, REQUEST FOR INFORMATION NOT RESPONDED TO AND/OR DIMENSIONS NOT FURNISHED WILL PLACE AFFECTED STEEL ON HOLD.

JEFFORDS STEEL AND ENGINEERING ASSUMES NO RESPONSIBILITY FOR ERRORS RESULTING FROM CONFLICTS IN CONTRACT DRAWINGS (ARCHITECTURAL/ STRUCTURAL).

GENERAL NOTES:

CHARGES FOR CORRECTIVE WORK WILL NOT BE HONORED UNLESS
PREVIOUS APPROVAL IS OBTAINED FROM JEFFORDS STEEL AND
ENGINEERING COMPANY.

MEMBERS ARE TO BE ERECTED SO THAT MARKED END IS IN THE
SAME LOCATION AS ON THE ERECTION DRAWING.



DRAWINGS PREPARED BY,
GLOBAL DETAILING, INC.
JOB # 12-396

1	APP	3-7
2	FIELD	4-12

job no. 4503
date 3-12
drawn by TC
checked by - GRI

revisions		
rev#	date	description

Jeffords
STEEL AND ENGINEERING COMPANY
P.O. BOX 40-4398 ROUTE #22
PLATTSBURGH, N.Y. 12901
518-561-4061


customer

ENCOMPASS DEVELOP
DESIGN CONSTRUCTION

AKWESASNE MOHAWK HOTEL
873 STATE HIGHWAY 37
AKWESASNE, NY

sheet

E1

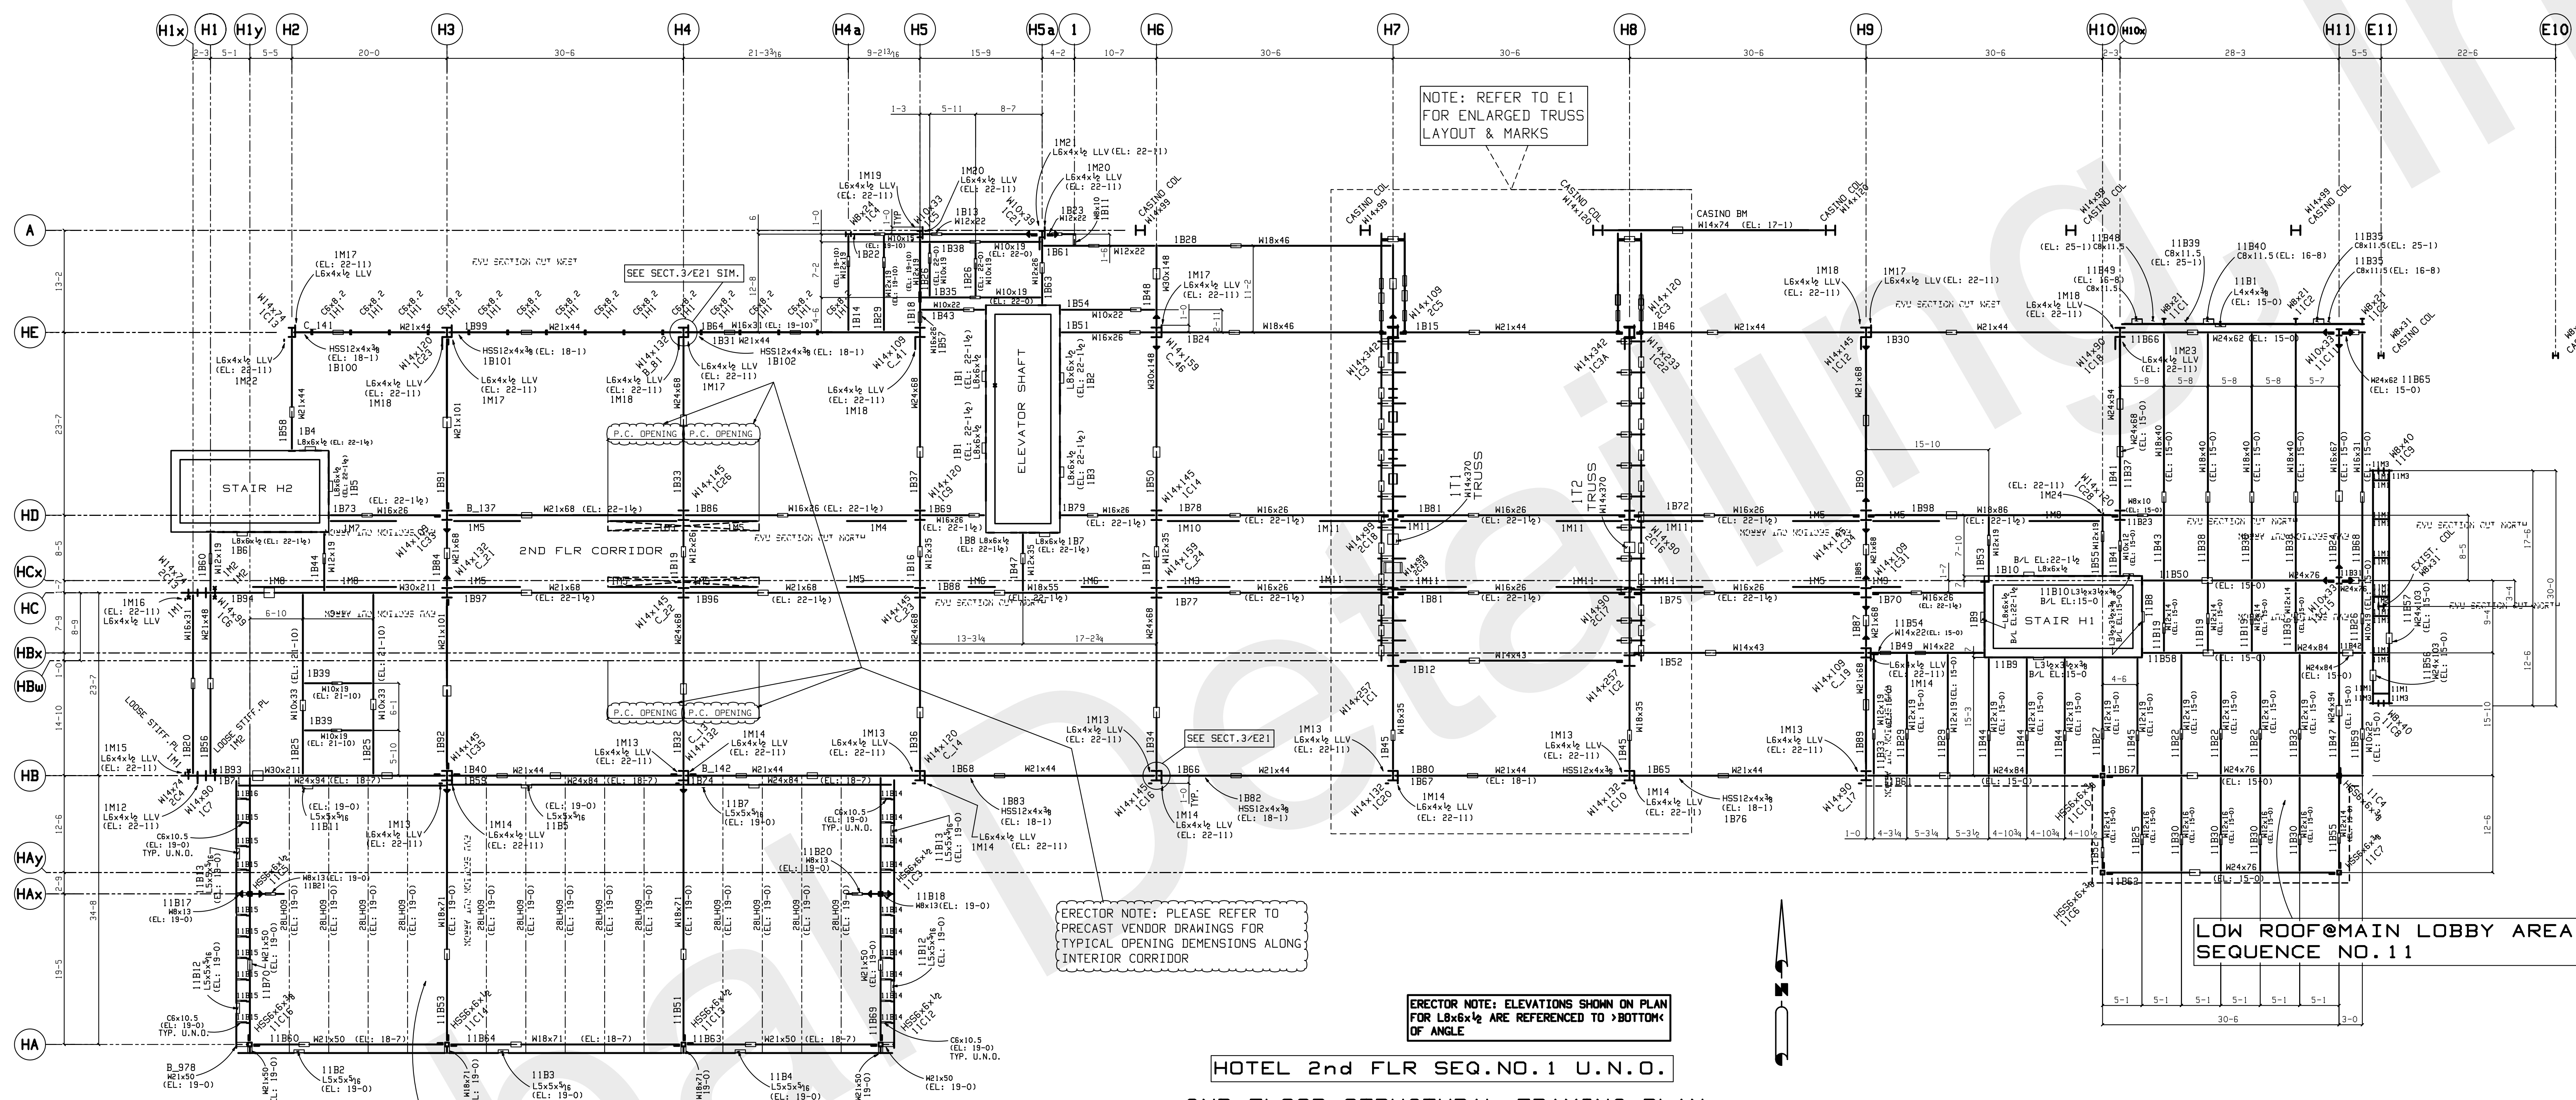

HOTEL 2nd FLR SEQ.NO.1 U.N.O.

2ND FLOOR STRUCTURAL FRAMING PLAN

- 1) TYPICAL TOP OF STEEL EL. 22'-2" (-1'-0") U.N.O. REFERENCED FROM TOP OF FINISHED 2ND FLOOR SLAB EL. 23'-2"
- 2) REFER TO "E" PLANS FOR DETAILS AND SECTIONS NOT SHOWN.
- 3) JOIST SHOWN FOR REFERENCE ONLY. REFER TO JOIST MFG. DRAWINGS FOR INFORMATION REGARDING JOIST, DECK, etc.
- 4) REFER TO PRECAST MFG. DRAWINGS FOR PC DETAILS, PC OPENINGS, etc.

LOW ROOF@POOL AREA
SEQUENCE NO. 11

LOW ROOF@MAIN LOBBY AREA
SEQUENCE NO. 11

ERECTOR NOTE: PLEASE REFER TO
PRECAST VENDOR DRAWINGS FOR
TYPICAL OPENING DIMENSIONS ALONG
INTERIOR CORRIDOR

ERECTOR NOTE: ELEVATIONS SHOWN ON PLAN
FOR L8x6x1/2 ARE REFERENCED TO BOTTOM
OF ANGLE

ALL VERIFIES, REQUEST FOR INFORMATION NOT
RESPONDED TO AND/OR DIMENSIONS NOT FURNISHED
WILL PLACE AFFECTED STEEL ON HOLD.


JEFFORDS STEEL AND ENGINEERING ASSUMES NO
RESPONSIBILITY FOR ERRORS RESULTING FROM
CONFLICTS IN CONTRACT DRAWINGS (ARCHITECTURAL/
STRUCTURAL).

GENERAL NOTES:

CHARGES FOR CORRECTIVE WORK WILL NOT BE HONORED UNLESS
PREVIOUS APPROVAL IS OBTAINED FROM JEFFORDS STEEL AND
ENGINEERING COMPANY.

MEMBERS ARE TO BE ERRECTED SO THAT MARKED END IS IN THE
SAME LOCATION AS ON THE ERECTION DRAWING.

DRAWINGS PREPARED BY:
GLOBAL DETAILING, INC.
JOB # 12-396

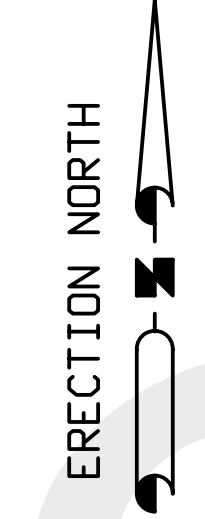

print record

1 APP 3-12

2 FIELD 4-12

job no. 4003

date 3-12

drawn by TC

checked by - GRI

revisions

description

date

rev#

Customer

ENCOMPASS DEVELOP

DESIGN CONSTRUCTION

Project

AKWESASNE MOHAWK HOTEL

873 STATE HIGHWAY 37

AKWESASNE, NY

sheet


E1A


Steel and Engineering Company

PO BOX 188 ROUTE 422

PITTSBURGH, NY 15201

518-561-4061

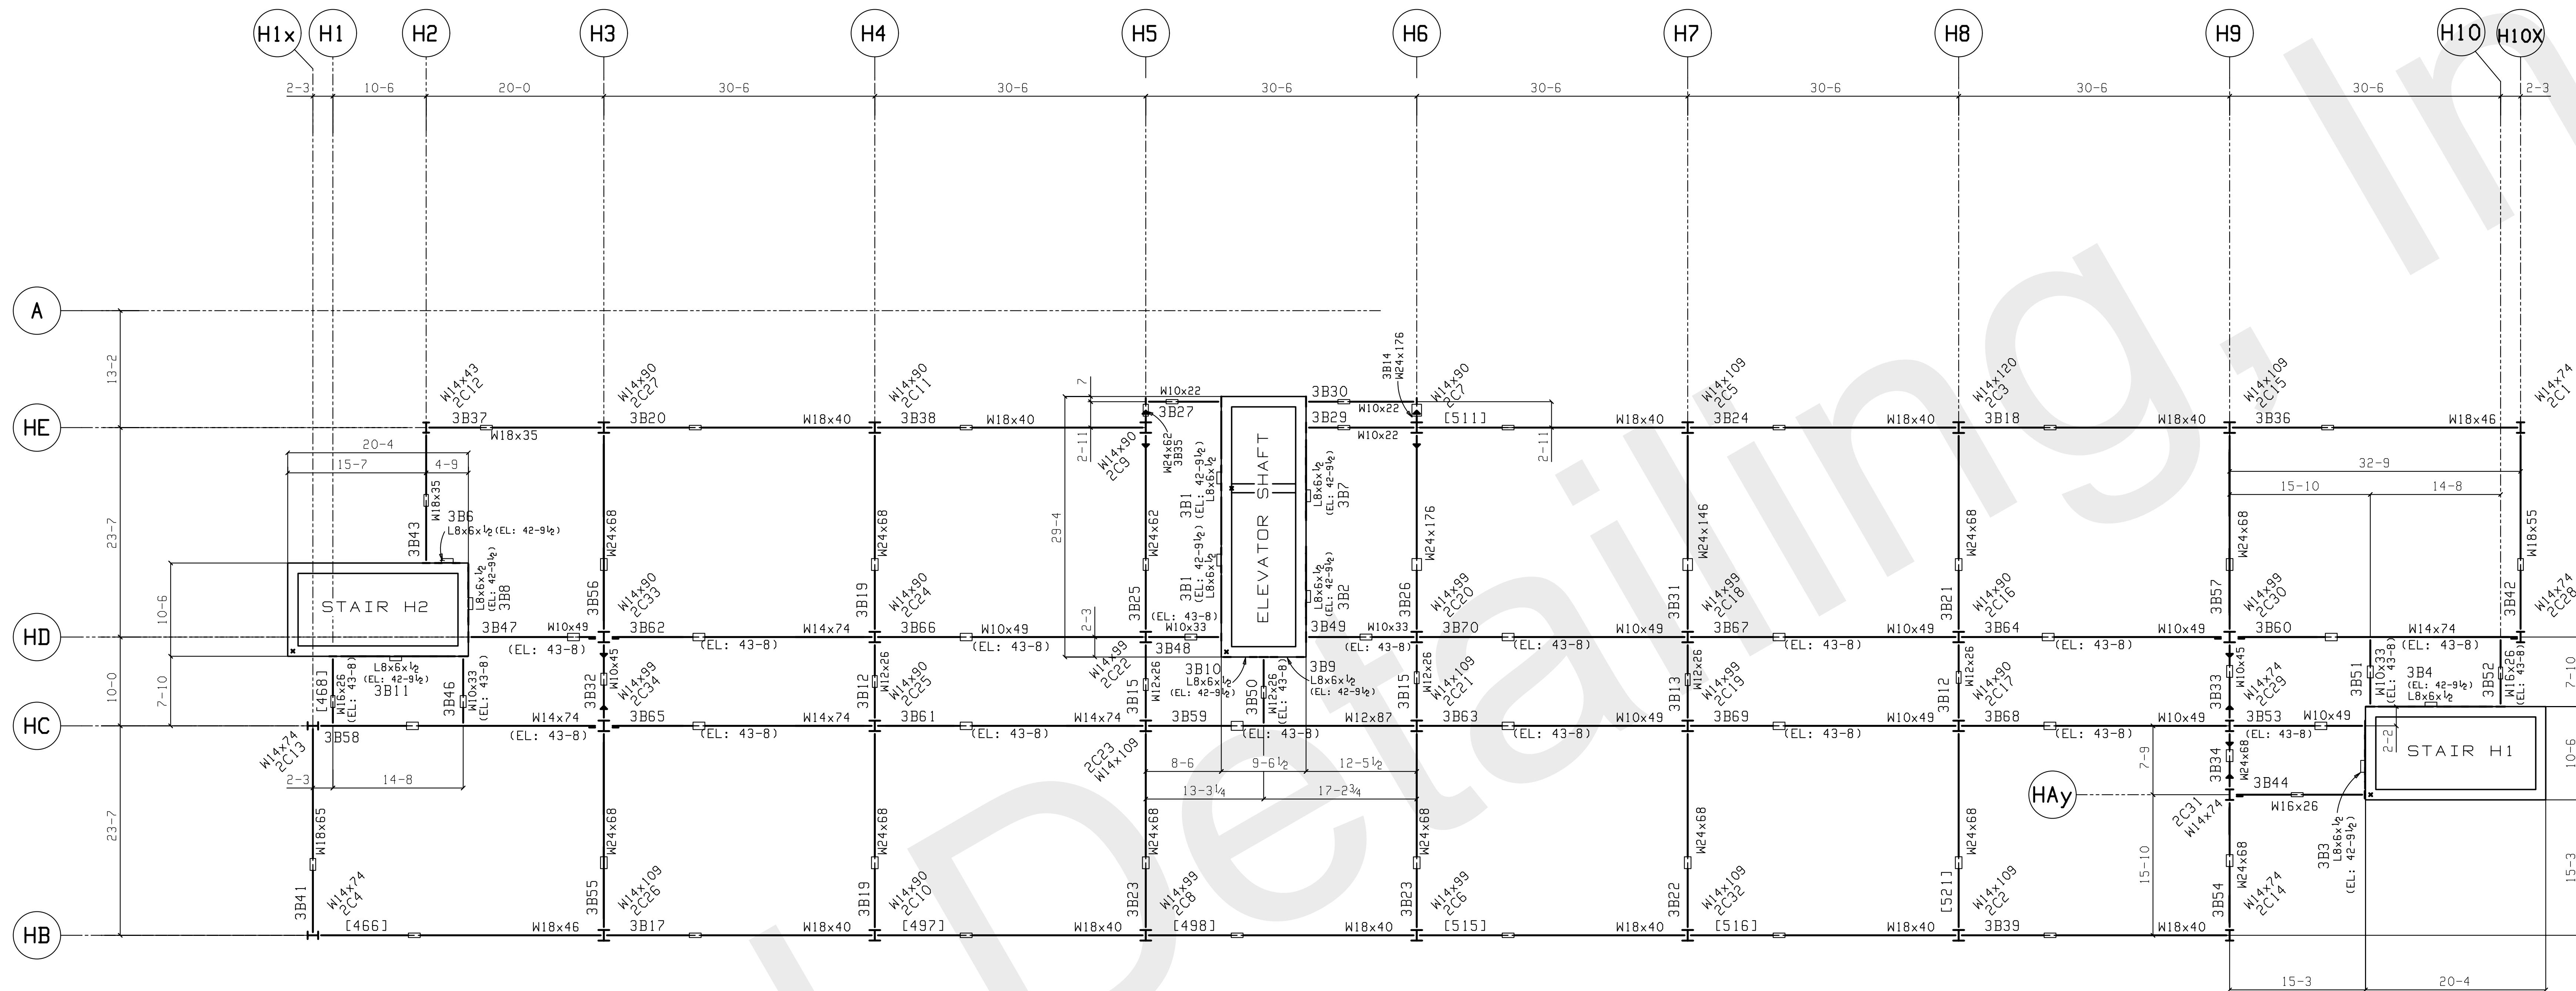

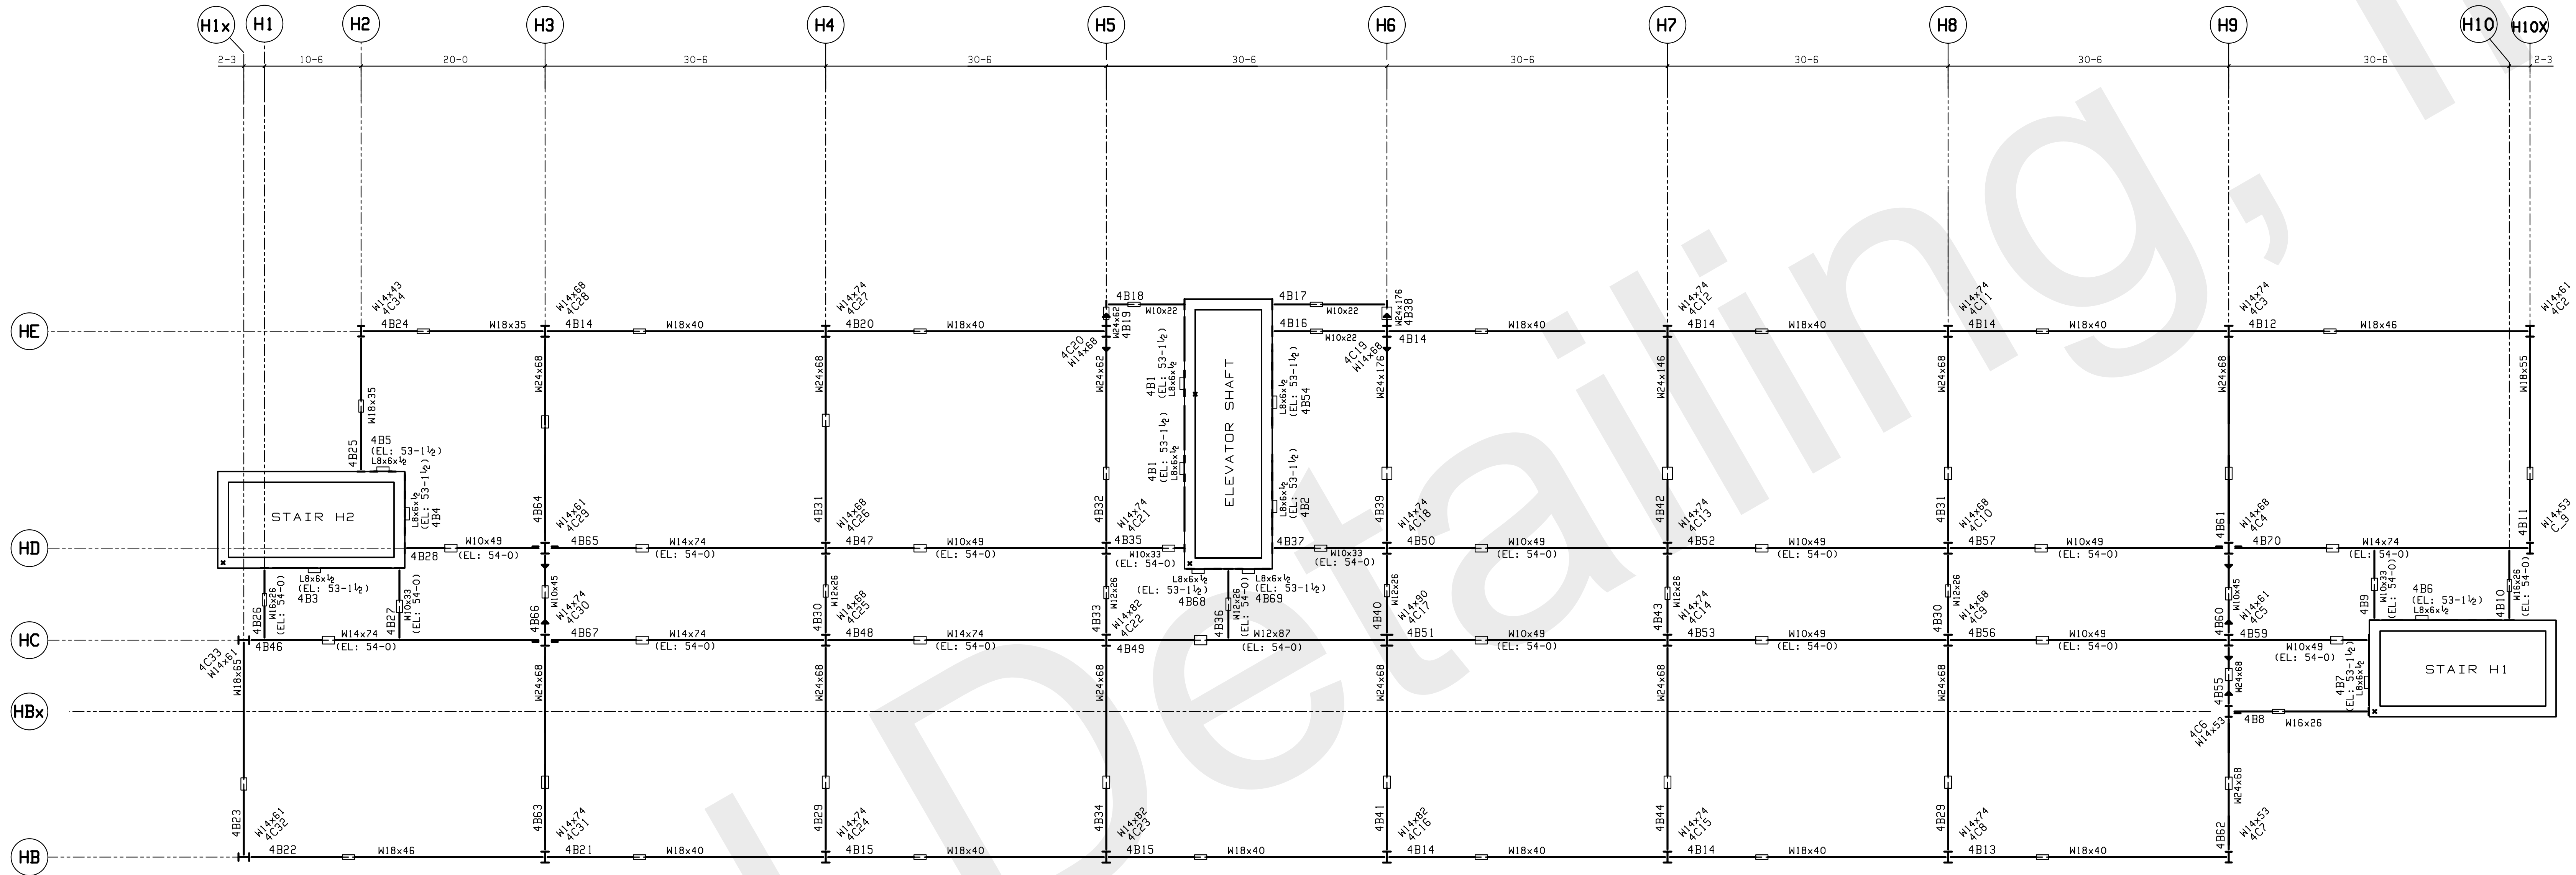

ERECTOR NOTE: ELEVATIONS SHOWN ON PLAN
FOR L8x6x1/2 ARE REFERENCED TO >BOTTOM<
OF ANGLE

SEQUENCE NO. 4

5TH FLOOR STRUCTURAL FRAMING PLAN

- 1) TYPICAL TOP OF STEEL EL. 53'-2" (-1'-0") U.N.O. REFERENCED FROM TOP OF FINISHED 5TH FLOOR SLAB EL. 54'-2".
- 2) REFER TO 'E'-PLANS FOR DETAILS AND SECTIONS NOT SHOWN.
- 3) REFER TO PRECAST MFG. DRAWINGS FOR PC DETAILS, PC OPENINGS...etc

ALL VERIFIES, REQUEST FOR INFORMATION NOT
RESPONDED TO AND/OR DIMENSIONS NOT FURNISHED
WILL PLACE AFFECTED STEEL ON HOLD.

JEFFORDS STEEL AND ENGINEERING ASSUMES NO
RESPONSIBILITY FOR ERRORS RESULTING FROM
CONFLICTS IN CONTRACT DRAWINGS (ARCHITECTURAL/
STRUCTURAL).

GENERAL NOTES:

CHARGES FOR CORRECTIVE WORK WILL NOT BE HONORED UNLESS
PREVIOUS APPROVAL IS OBTAINED FROM JEFFORDS STEEL AND
ENGINEERING COMPANY.

MEMBERS ARE TO BE ERECTED SO THAT MARKED END IS IN THE
SAME LOCATION AS ON THE ERECTION DRAWING.

DRAWINGS PREPARED BY:
GLOBAL DETAILING, INC.
JOB # 12-396

ERECTION NORTH

print record					
1	REVISED				

job no. 400	date 3-12	drawn by TC	checked by - GDI
-------------	-----------	-------------	------------------


rev#	date	description

STEEL AND ENGINEERING COMPANY
P.O. BOX 400, ROUTE 422
FELTSMITH, N.Y. 12001
518-561-4061

ENCOMPASS DEVELOP
DESIGN CONSTRUCTION

AKWESASNE MOHAWK HOTEL
873 STATE HIGHWAY 37
AKWESASNE, NY

sheet
E4

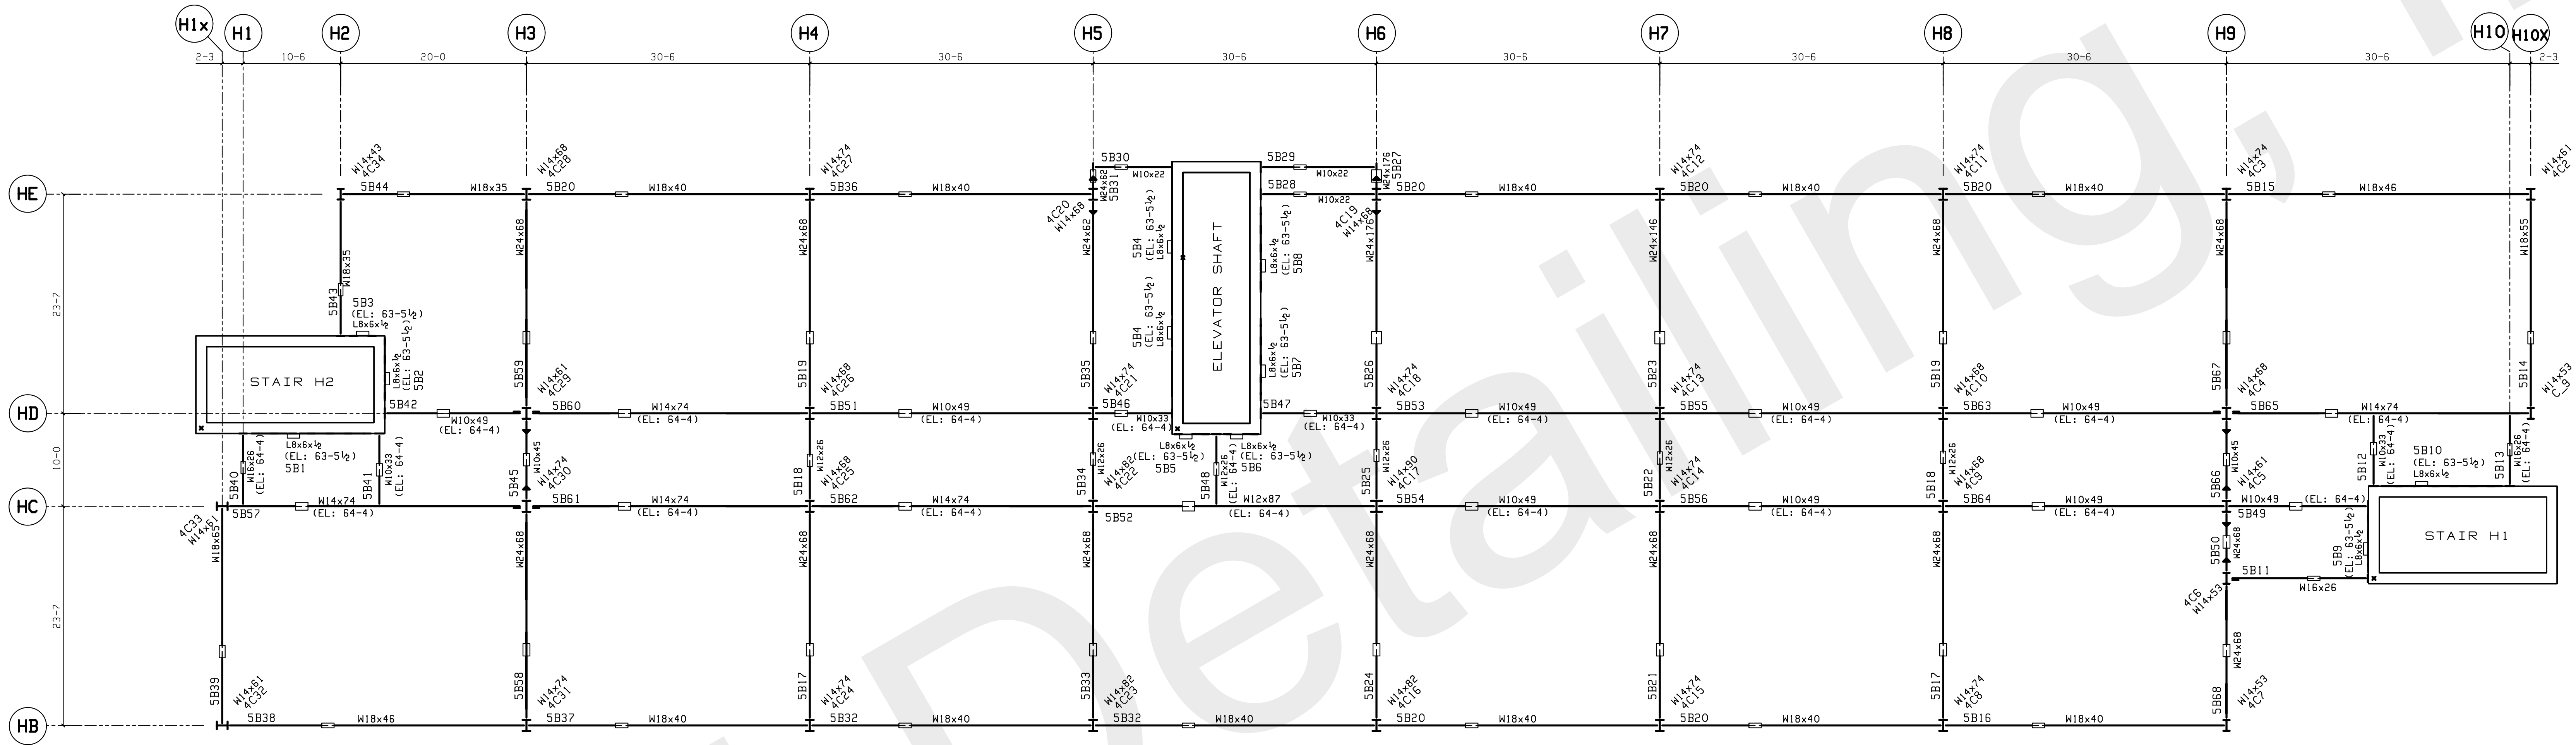

ERECTOR NOTE: ELEVATIONS SHOWN ON PLAN
FOR L8x6x1/2 ARE REFERENCED TO >BOTTOM<
OF ANGLE

SEQUENCE NO. 5

6TH FLOOR STRUCTURAL FRAMING PLAN

- 1) TYPICAL TOP OF STEEL EL. 63'-6" (-1'-0") U.N.O. REFERENCED FROM TOP OF FINISHED 6TH FLOOR SLAB EL. 64'-6".
- 2) REFER TO 'E'-PLANS FOR DETAILS AND SECTIONS NOT SHOWN.
- 3) REFER TO PRECAST MFG. DRAWINGS FOR PC DETAILS, PC OPENINGS...etc

ALL VERIFIES, REQUEST FOR INFORMATION NOT
RESPONDED TO AND/OR DIMENSIONS NOT FURNISHED
WILL PLACE AFFECTED STEEL ON HOLD.

JEFFORDS STEEL AND ENGINEERING ASSUMES NO
RESPONSIBILITY FOR ERRORS RESULTING FROM
CONFLICTS IN CONTRACT DRAWINGS (ARCHITECTURAL/
STRUCTURAL).

GENERAL NOTES:

CHARGES FOR CORRECTIVE WORK WILL NOT BE HONORED UNLESS
PREVIOUS APPROVAL IS OBTAINED FROM JEFFORDS STEEL AND
ENGINEERING COMPANY.

MEMBERS ARE TO BE ERRECTED SO THAT MARKED END IS IN THE
SAME LOCATION AS ON THE ERECTION DRAWING.

DRAWINGS PREPARED BY,
GLOBAL DETAILING, INC.
JOB # 12-396

ERECTION NORTH

print record					
1	JEFFORDS	11.12			

job no. 400	date 3-12	drawn by TC	checked by - GDI
-------------	-----------	-------------	------------------


rev#	date	description

JEFFORDS
STEEL AND ENGINEERING COMPANY
P.O. BOX 188, ROUTE 422
PITTSBURGH, NY 15201
518-561-4061

Customer
ENCOMPASS DEVELOP
DESIGN CONSTRUCTION

Project
AKWESASNE MOHAWK HOTEL
873 STATE HIGHWAY 37
AKWESASNE, NY

sheet
E5

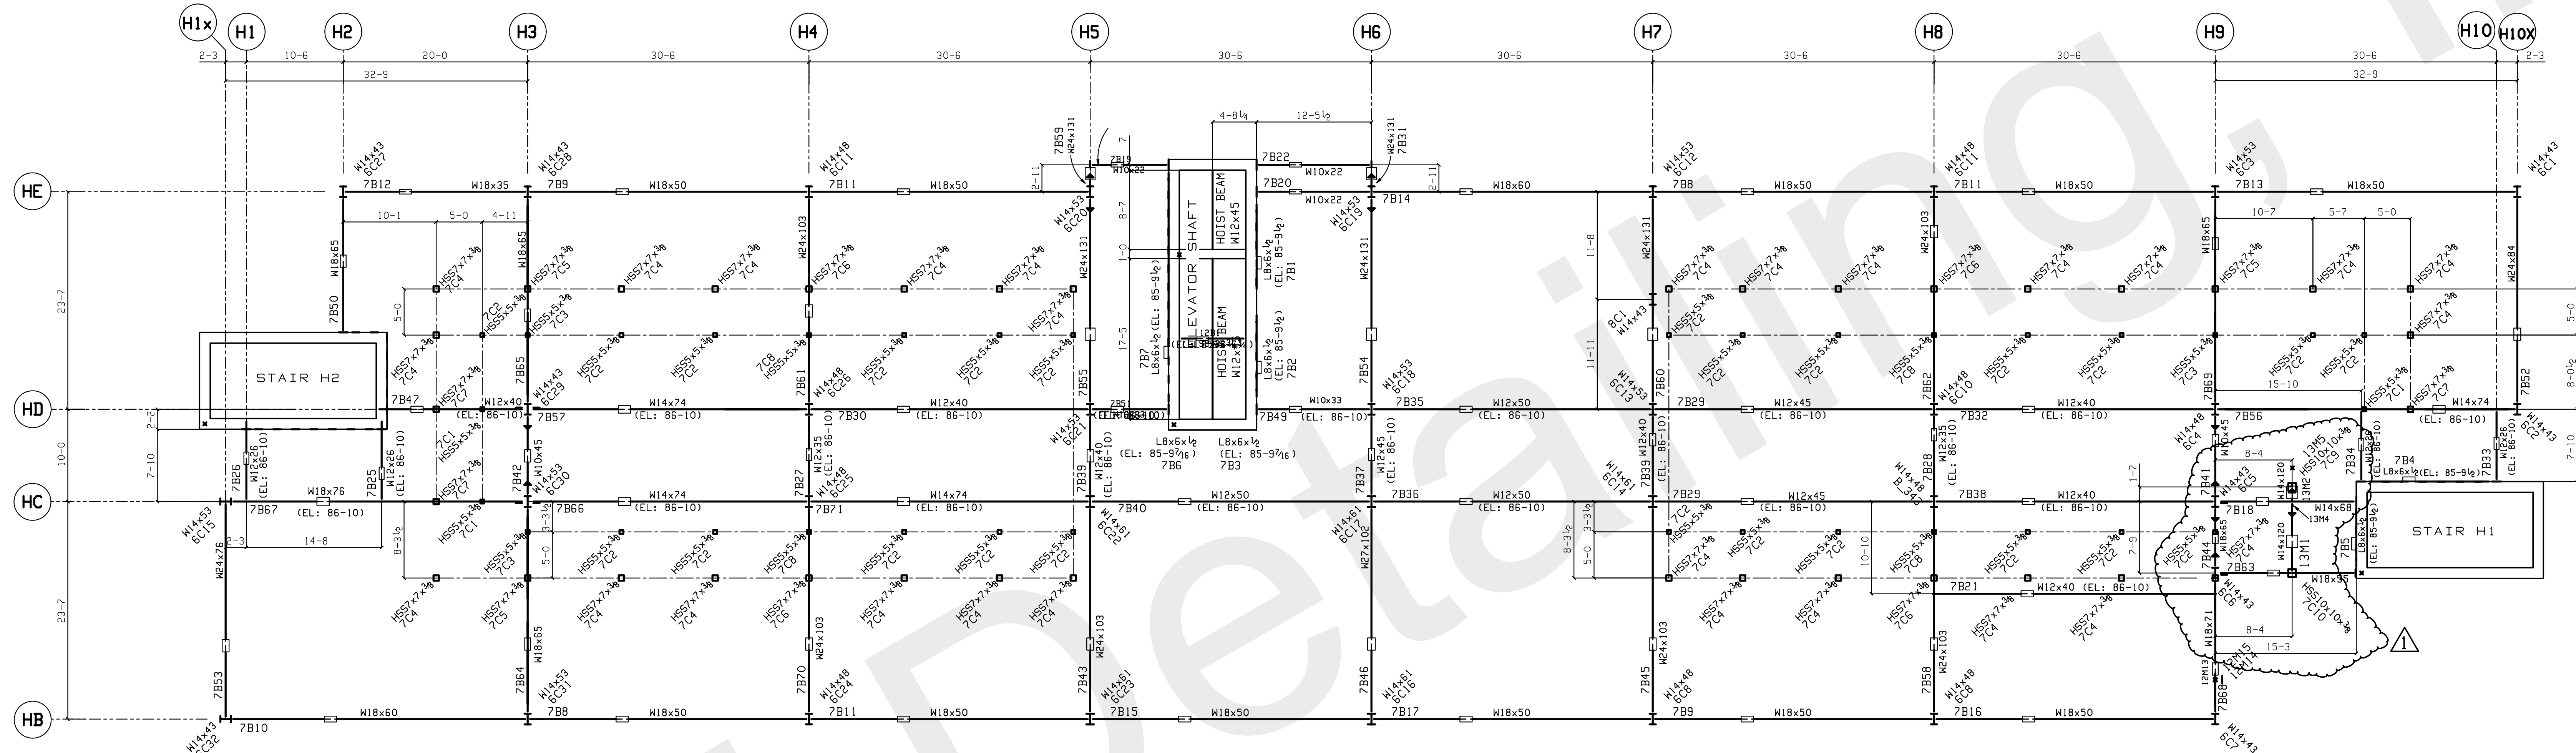

ERECTOR NOTE: ELEVATIONS SHOWN ON PLAN FOR L8x6x $\frac{1}{2}$ ARE REFERENCED TO >BOTTOM< OF ANGLE

SEQUENCE NO. 7

MAIN ROOF STRUCTURAL FRAMING PLAN

- 1) TYPICAL TOP OF STEEL EL. 85'-10" (-1'-2") U.N.O. REFERENCED FROM TOP OF FINISHED 7TH FLOOR SLAB EL. 87'-0".
- 2) REFER TO 'E'-PLANS FOR DETAILS AND SECTIONS NOT SHOWN.
- 3) REFER TO PRECAST MFG. DRAWINGS FOR PC DETAILS, PC OPENINGS...etc

ALL VERIFIES, REQUEST FOR INFORMATION NOT RESPONDED TO AND/OR DIMENSIONS NOT FURNISHED WILL PLACE AFFECTED STEEL ON HOLD.

JEFFORDS STEEL AND ENGINEERING ASSUMES NO RESPONSIBILITY FOR ERRORS RESULTING FROM CONFLICTS IN CONTRACT DRAWINGS (ARCHITECTURAL/STRUCTURAL).

GENERAL NOTES:

CHARGES FOR CORRECTIVE WORK WILL NOT BE HONORED UNLESS PREVIOUS APPROVAL IS OBTAINED FROM JEFFORDS STEEL AND ENGINEERING COMPANY.

MEMBERS ARE TO BE ERECTED SO THAT MARKED END IS IN THE SAME LOCATION AS ON THE ERECTION DRAWING.

DRAWINGS PREPARED BY:
GLOBAL DETAILING, INC.
JOB # 12-396

ERECTION NORTH

print record	
1	JEFFORDS
2	REVISION 1.6.13

job no. 4503
date 3-12
drawn by TC
checked by - GRI

rev#	date	description
1	1.6.13	ADDITIONAL BEAMS ADDED FOR PRECAST PANEL AND LUMEN SUPPORT AT MAIN ROOF

STEEL AND ENGINEERING COMPANY
701 BROADWAY, SUITE 402
PITTSBURGH, PA 15201
518-561-4061

JEFFORDS

ENCOMPASS DEVELOP
DESIGN CONSTRUCTION

Customer


AKWESASNE MOHAWK HOTEL
873 STATE HIGHWAY 37
AKWESASNE, NY

Project


sheet

E7




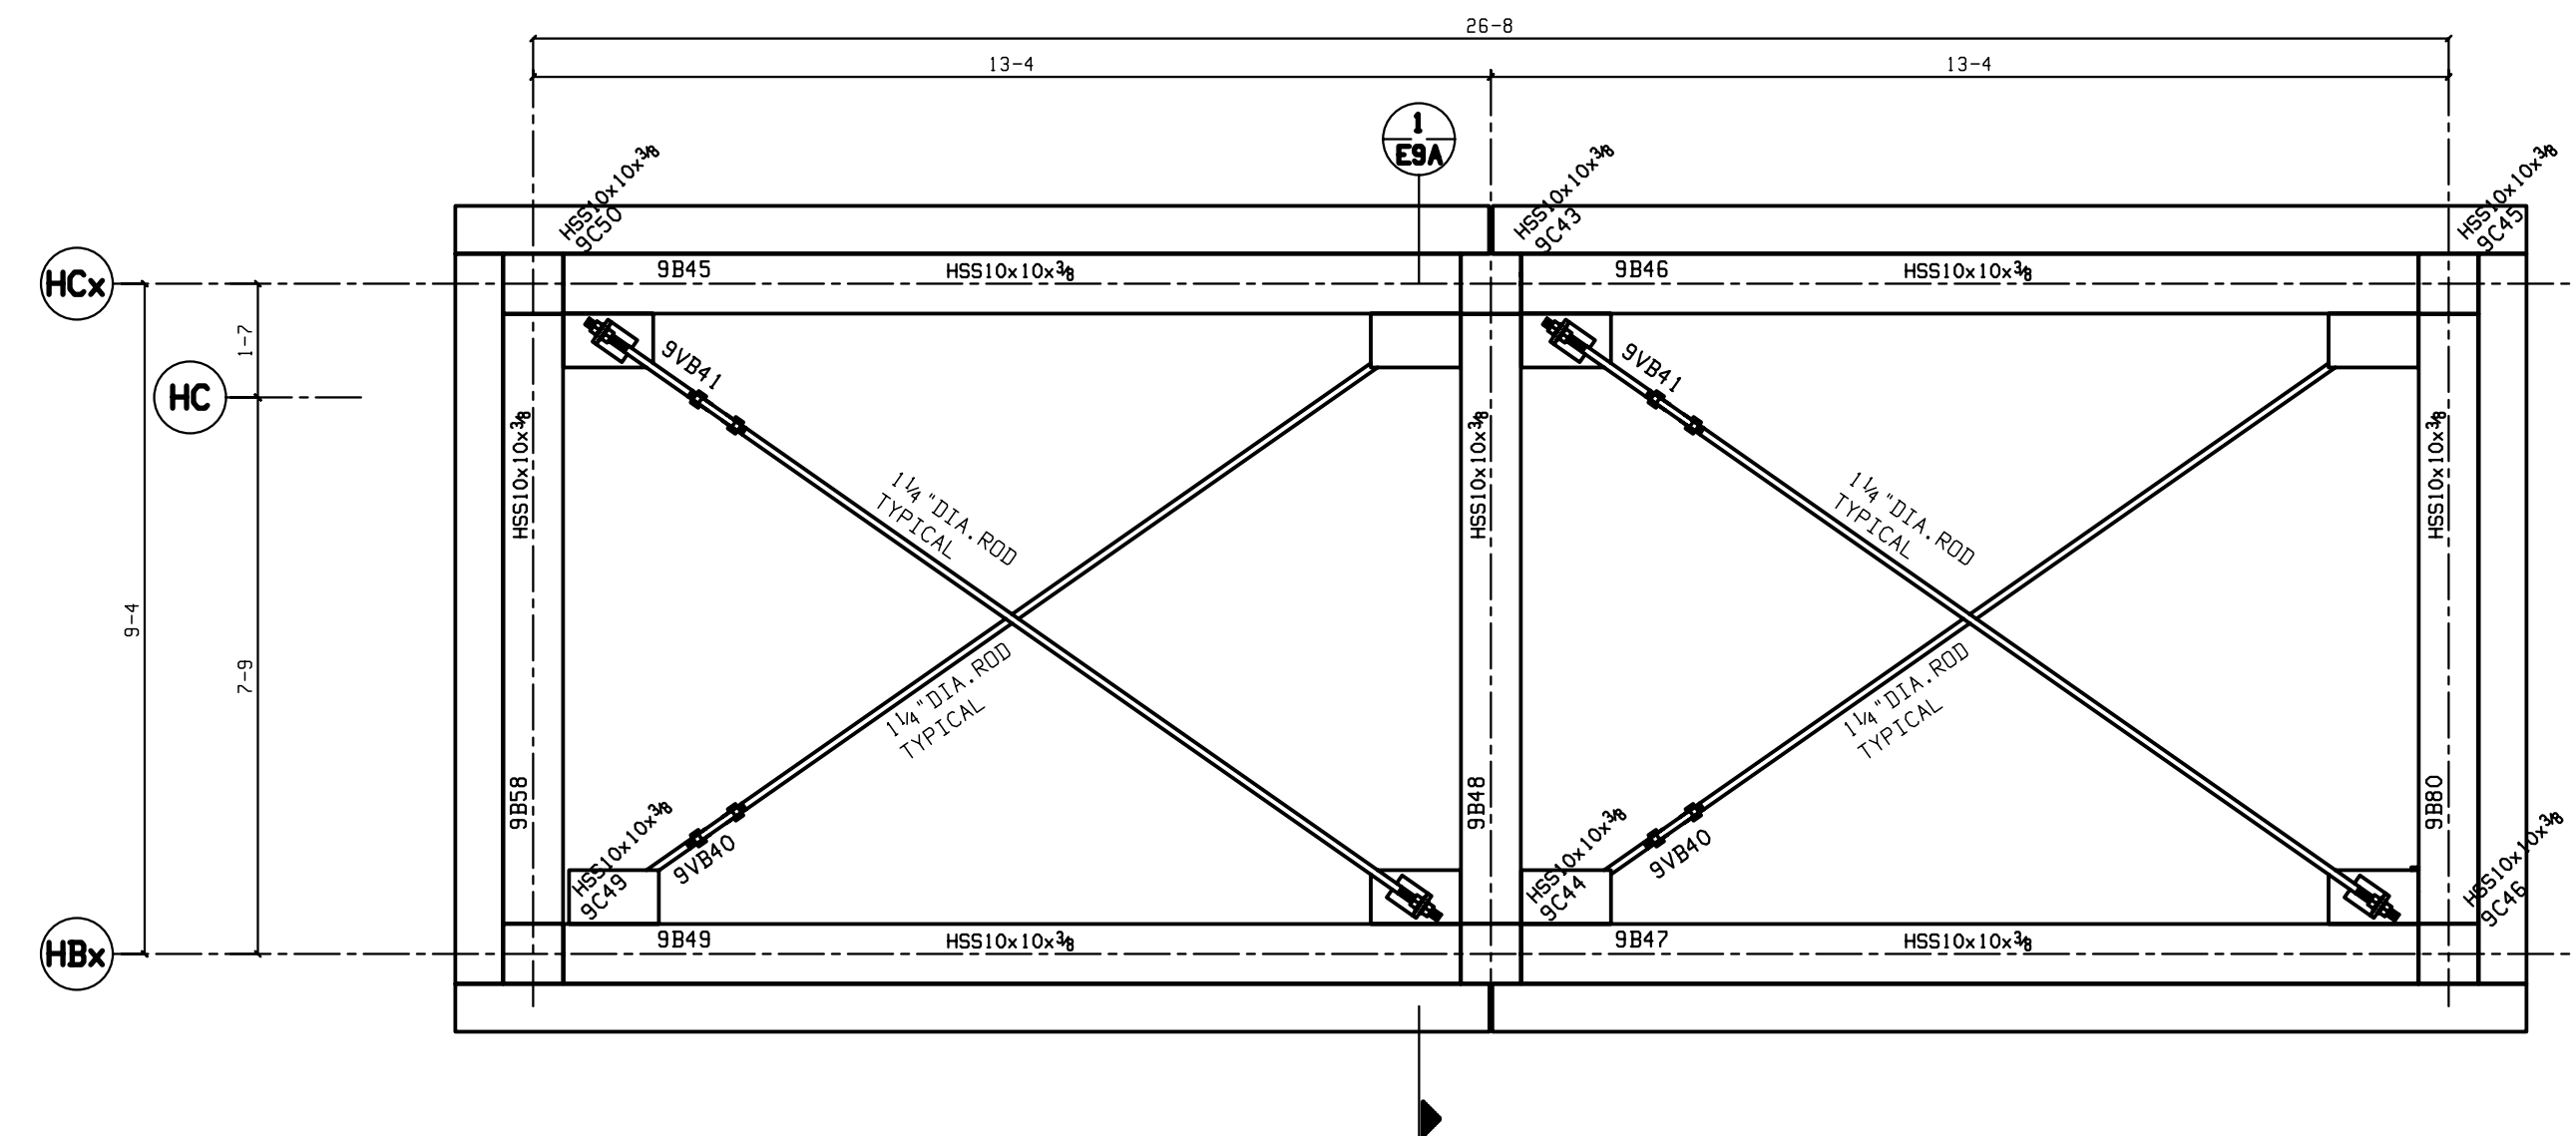

TOWER LANTERN FRAMING AT EL. 124'-10"
(REF. DESIGN DWG. HTL-S50-02-05)

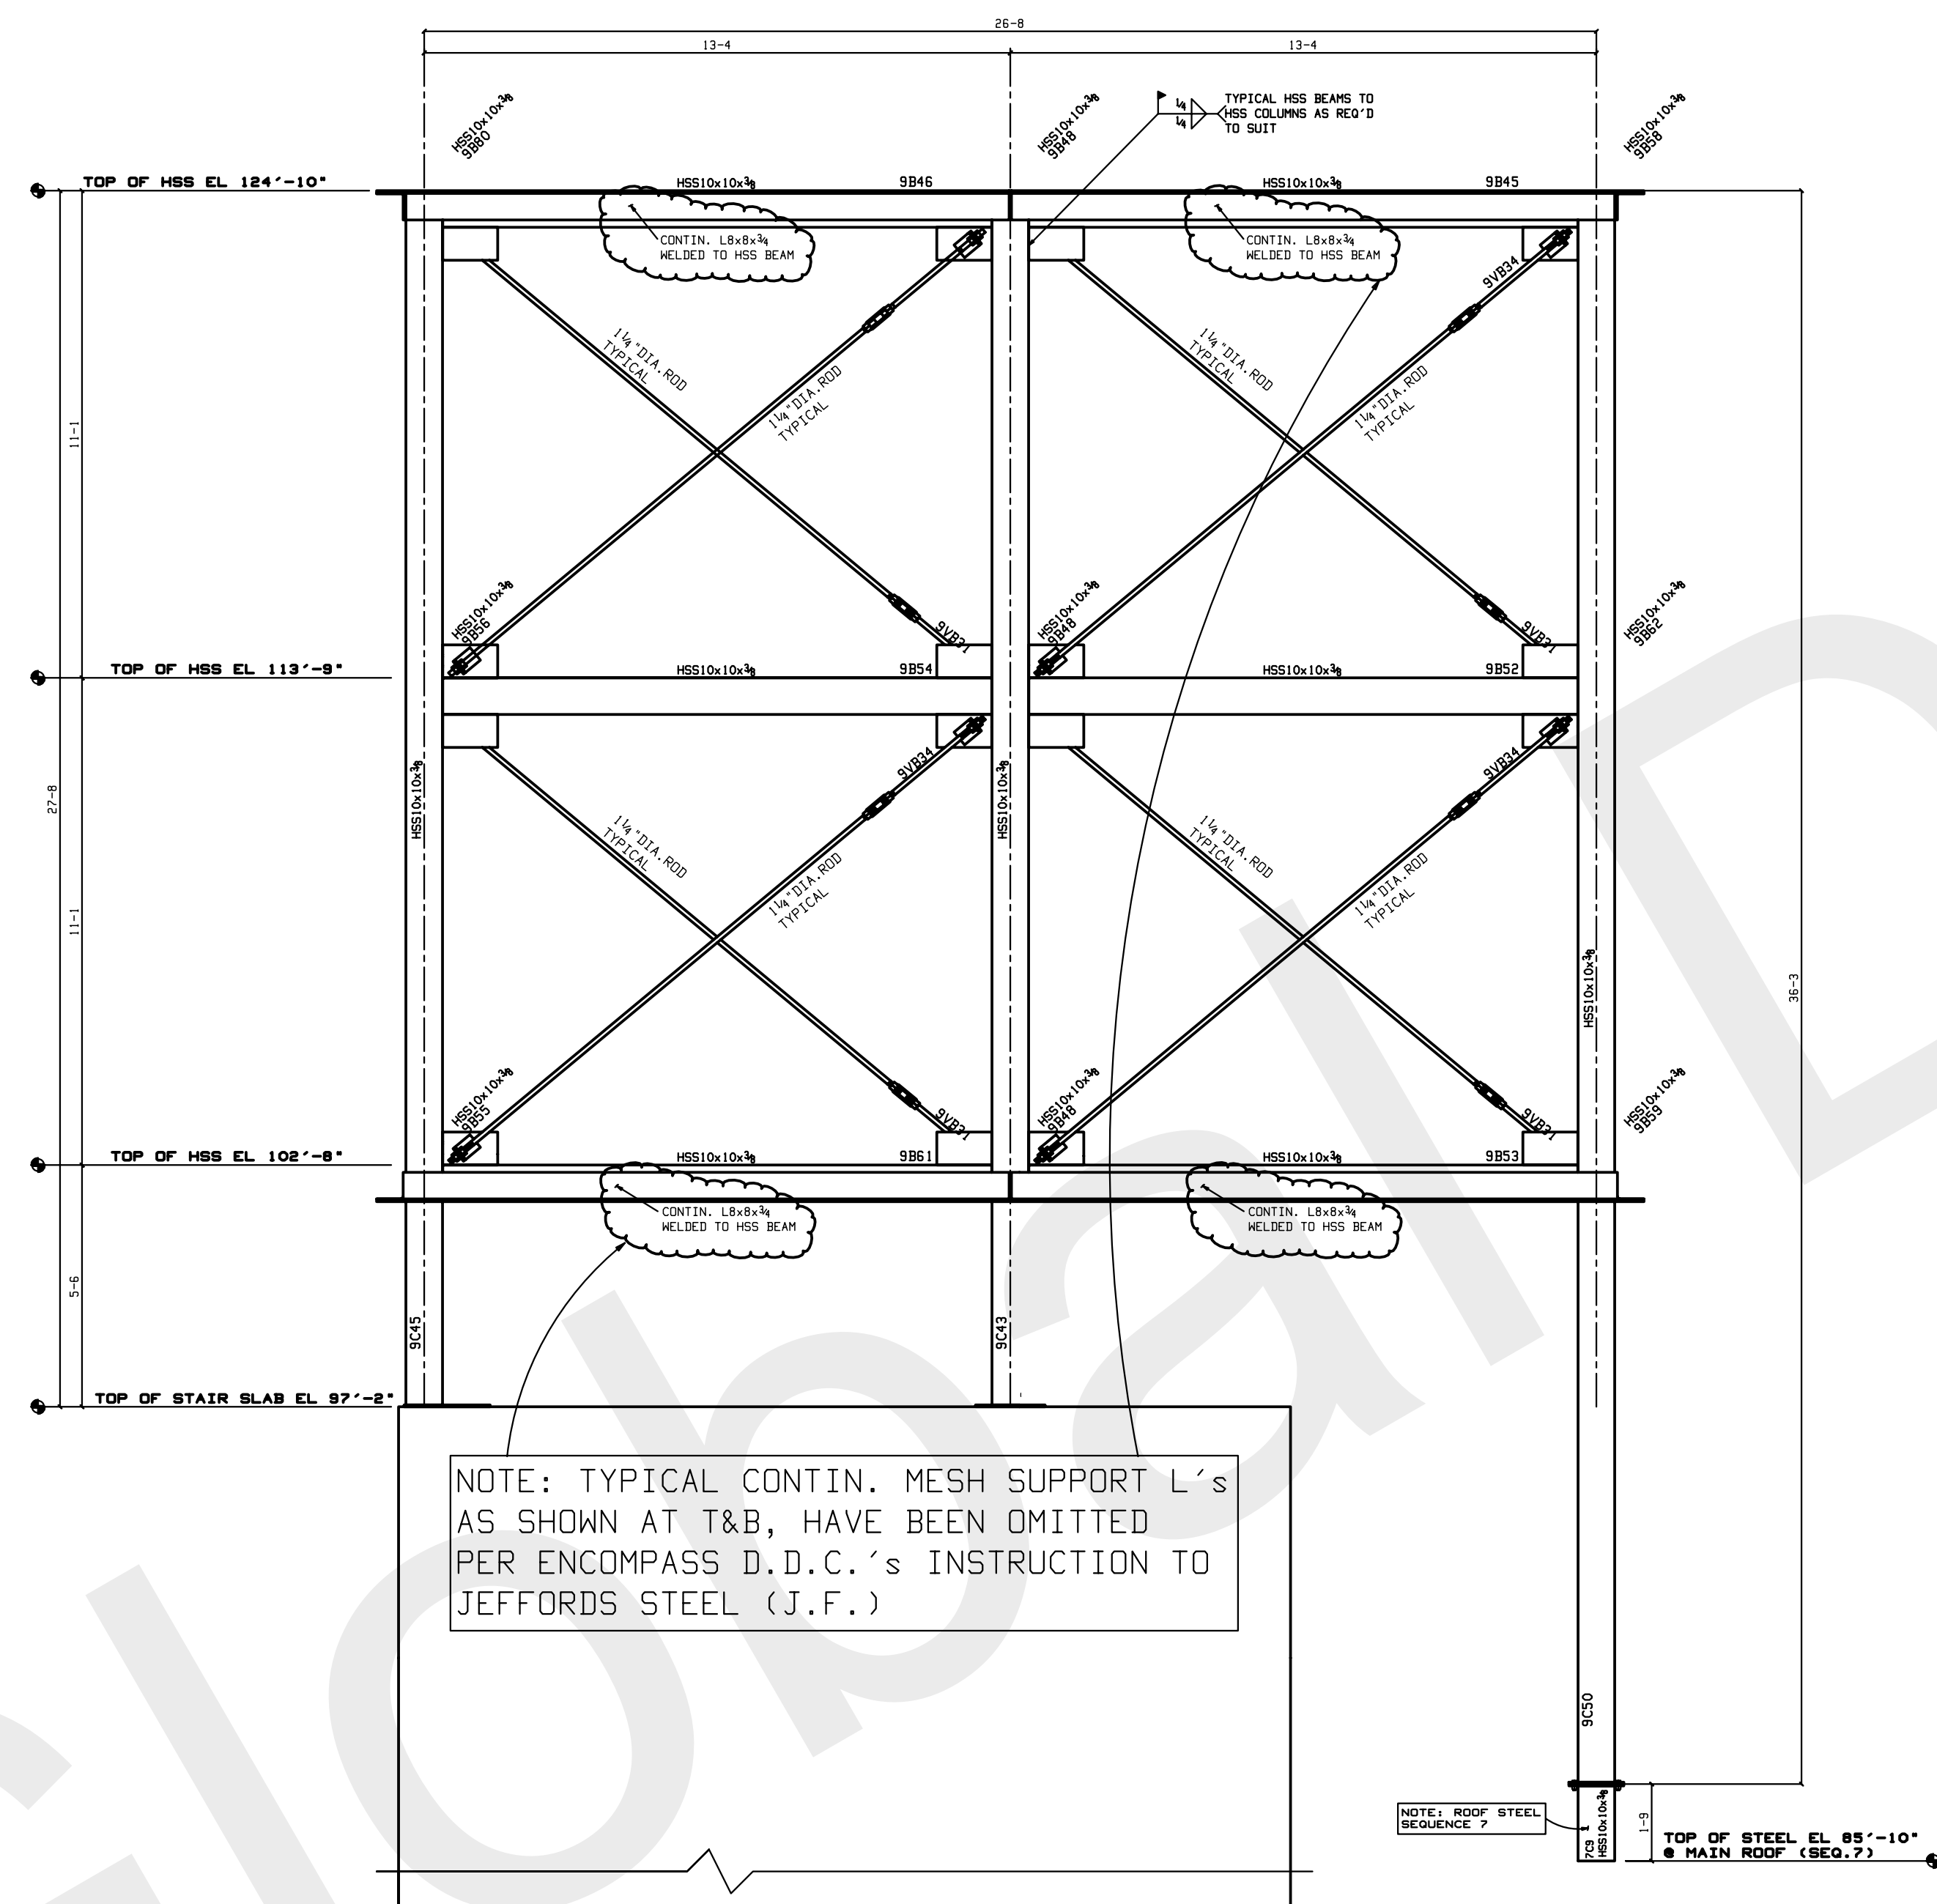

TOWER LANTERN NORTH ELEVATION
(LOOKING SOUTH)

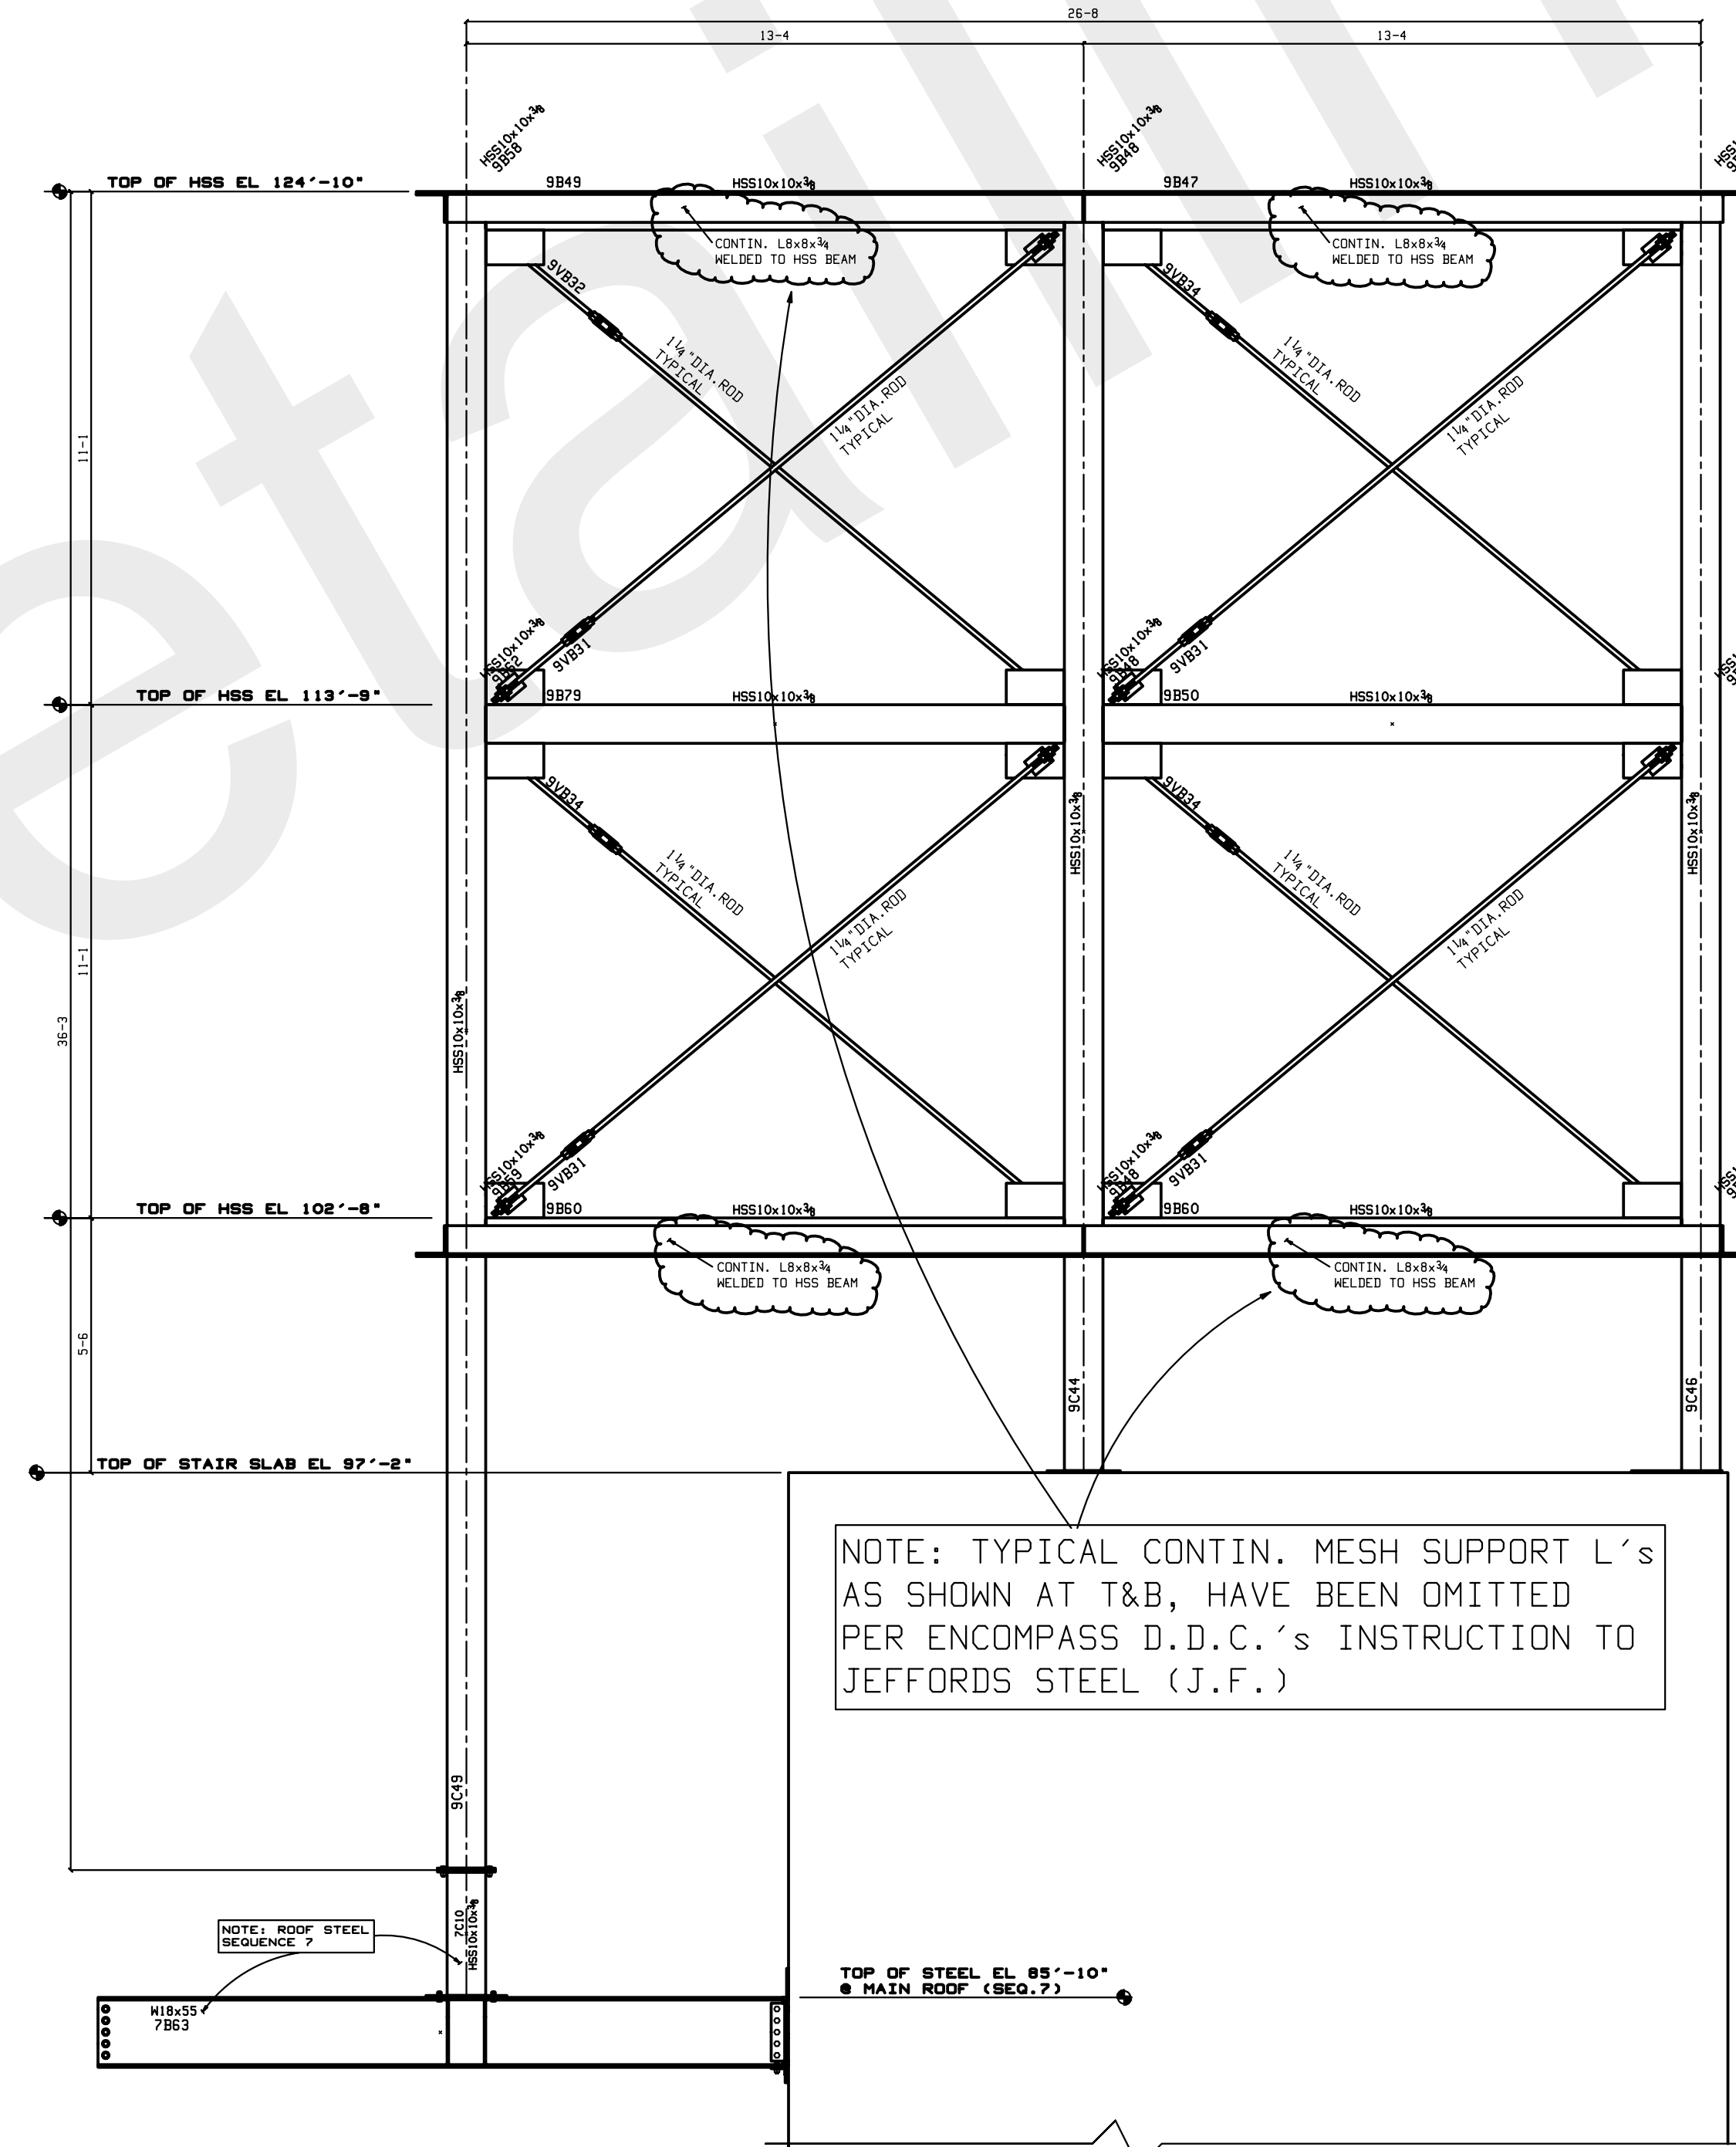

TOWER LANTERN SOUTH ELEVATION
(LOOKING NORTH)

ERECTOR NOTE: WORK THIS ERECTION SHEET
WITH ERECTION SHEET E9A

DRAWINGS PREPARED BY,
GLOBAL DETAILING, INC.
JOB # 12-396

GENERAL NOTES:
CHARGES FOR CORRECTIVE WORK WILL NOT BE HONORED UNLESS
PREVIOUS APPROVAL IS OBTAINED FROM JEFFORDS STEEL AND
ENGINEERING COMPANY.
MEMBERS ARE TO BE ERECTED SO THAT MARKED END IS IN THE
SAME LOCATION AS ON THE ERECTION DRAWING.

print record	APP. ONLY	DATE	BY	DATE	BY	DATE	BY
1	ONLY	6.22.22					
2	FILE	7.3.22					

job no.	date	drawn by	checked by
400	3-12	AD	GD


rev#	date	description
1		
2		
3		
4		
5		
6		
7		
8		
9		
10		

STEEL AND ENGINEERING COMPANY
P.O. BOX 188 ROUTE 422
PLATTSBURGH, NY 12501
518-561-4061


ENCOMPASS DEVELOP
DESIGN CONSTRUCTION

AKWESASNE MOHAWK HOTEL
873 STATE HIGHWAY 37
AKWESASNE, NY


sheet
E9

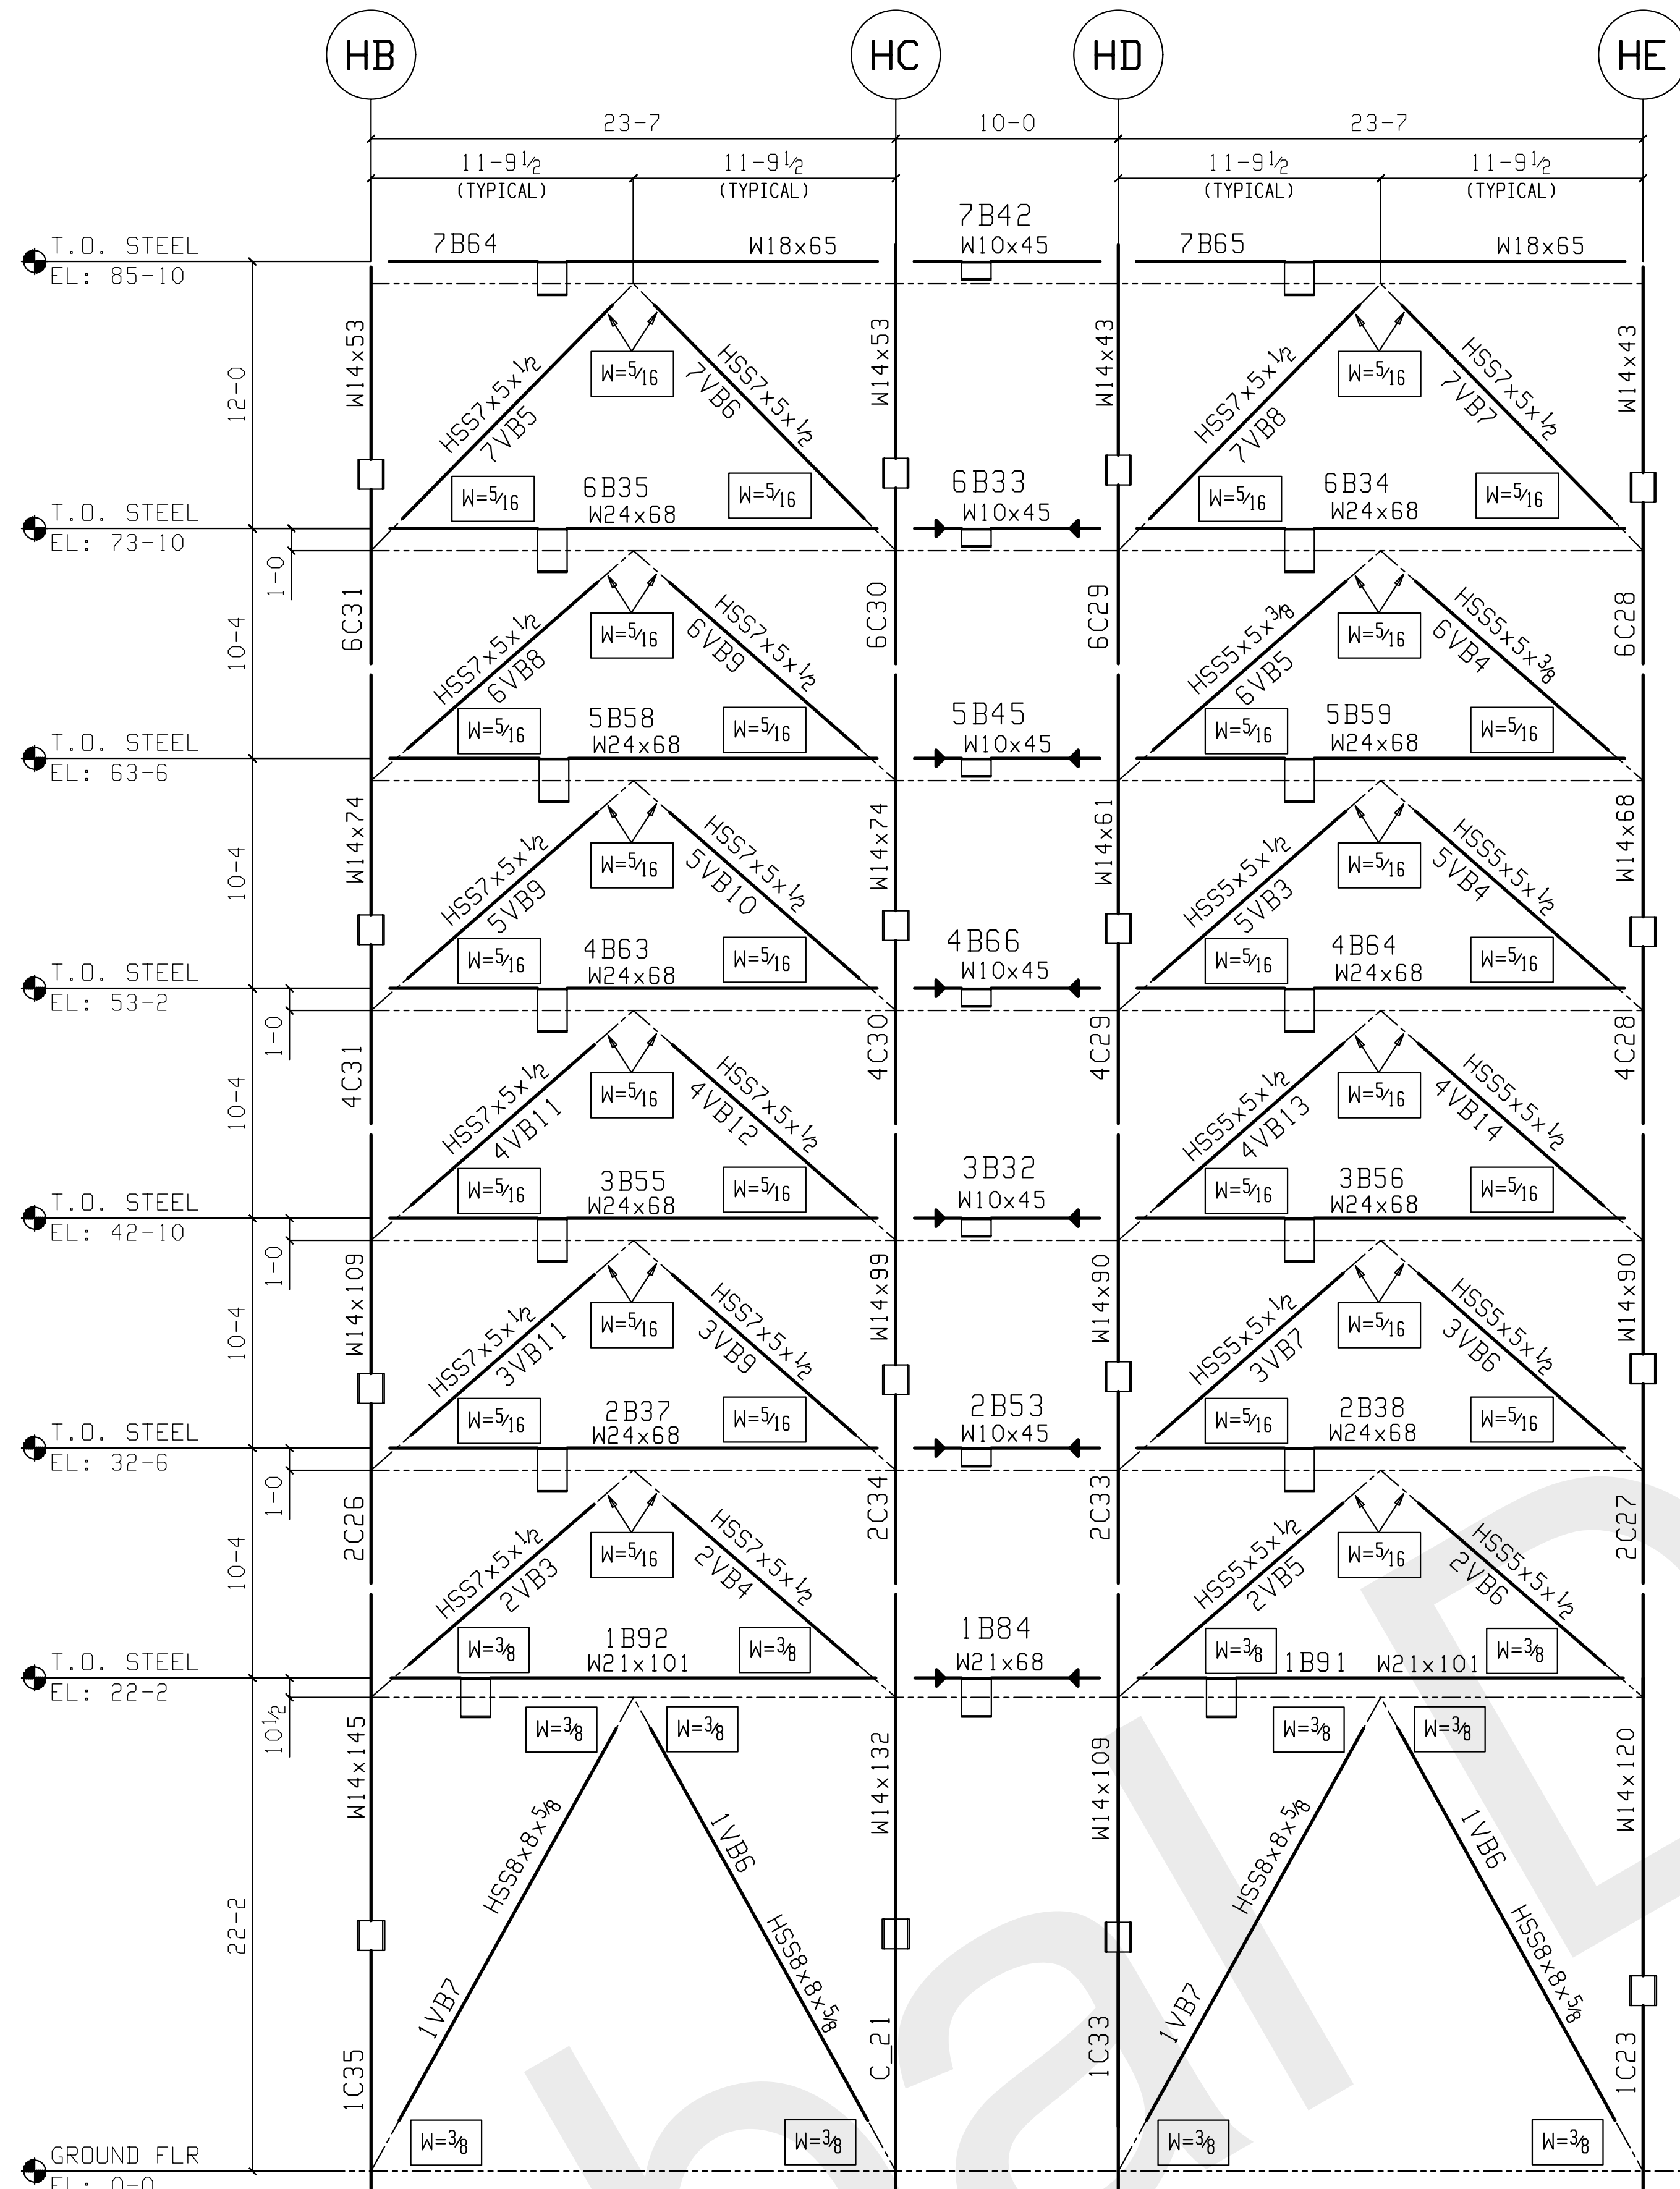

VERTICAL BRACE @ COLUMNLINE "H3"
(LOOKING WEST)

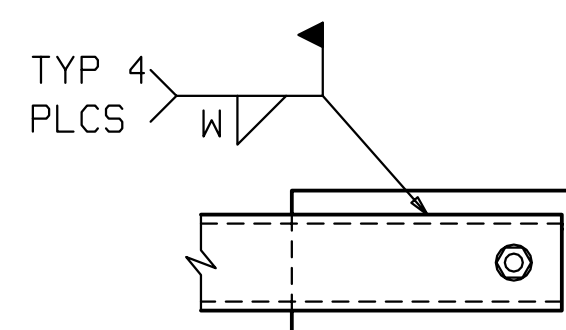

TYPICAL WELD CONNECTION AT
TUBE BRACE TO GUSSET PLATE
NOTE: W = WELD SIZE
(SEE BRACING ELEVATIONS)

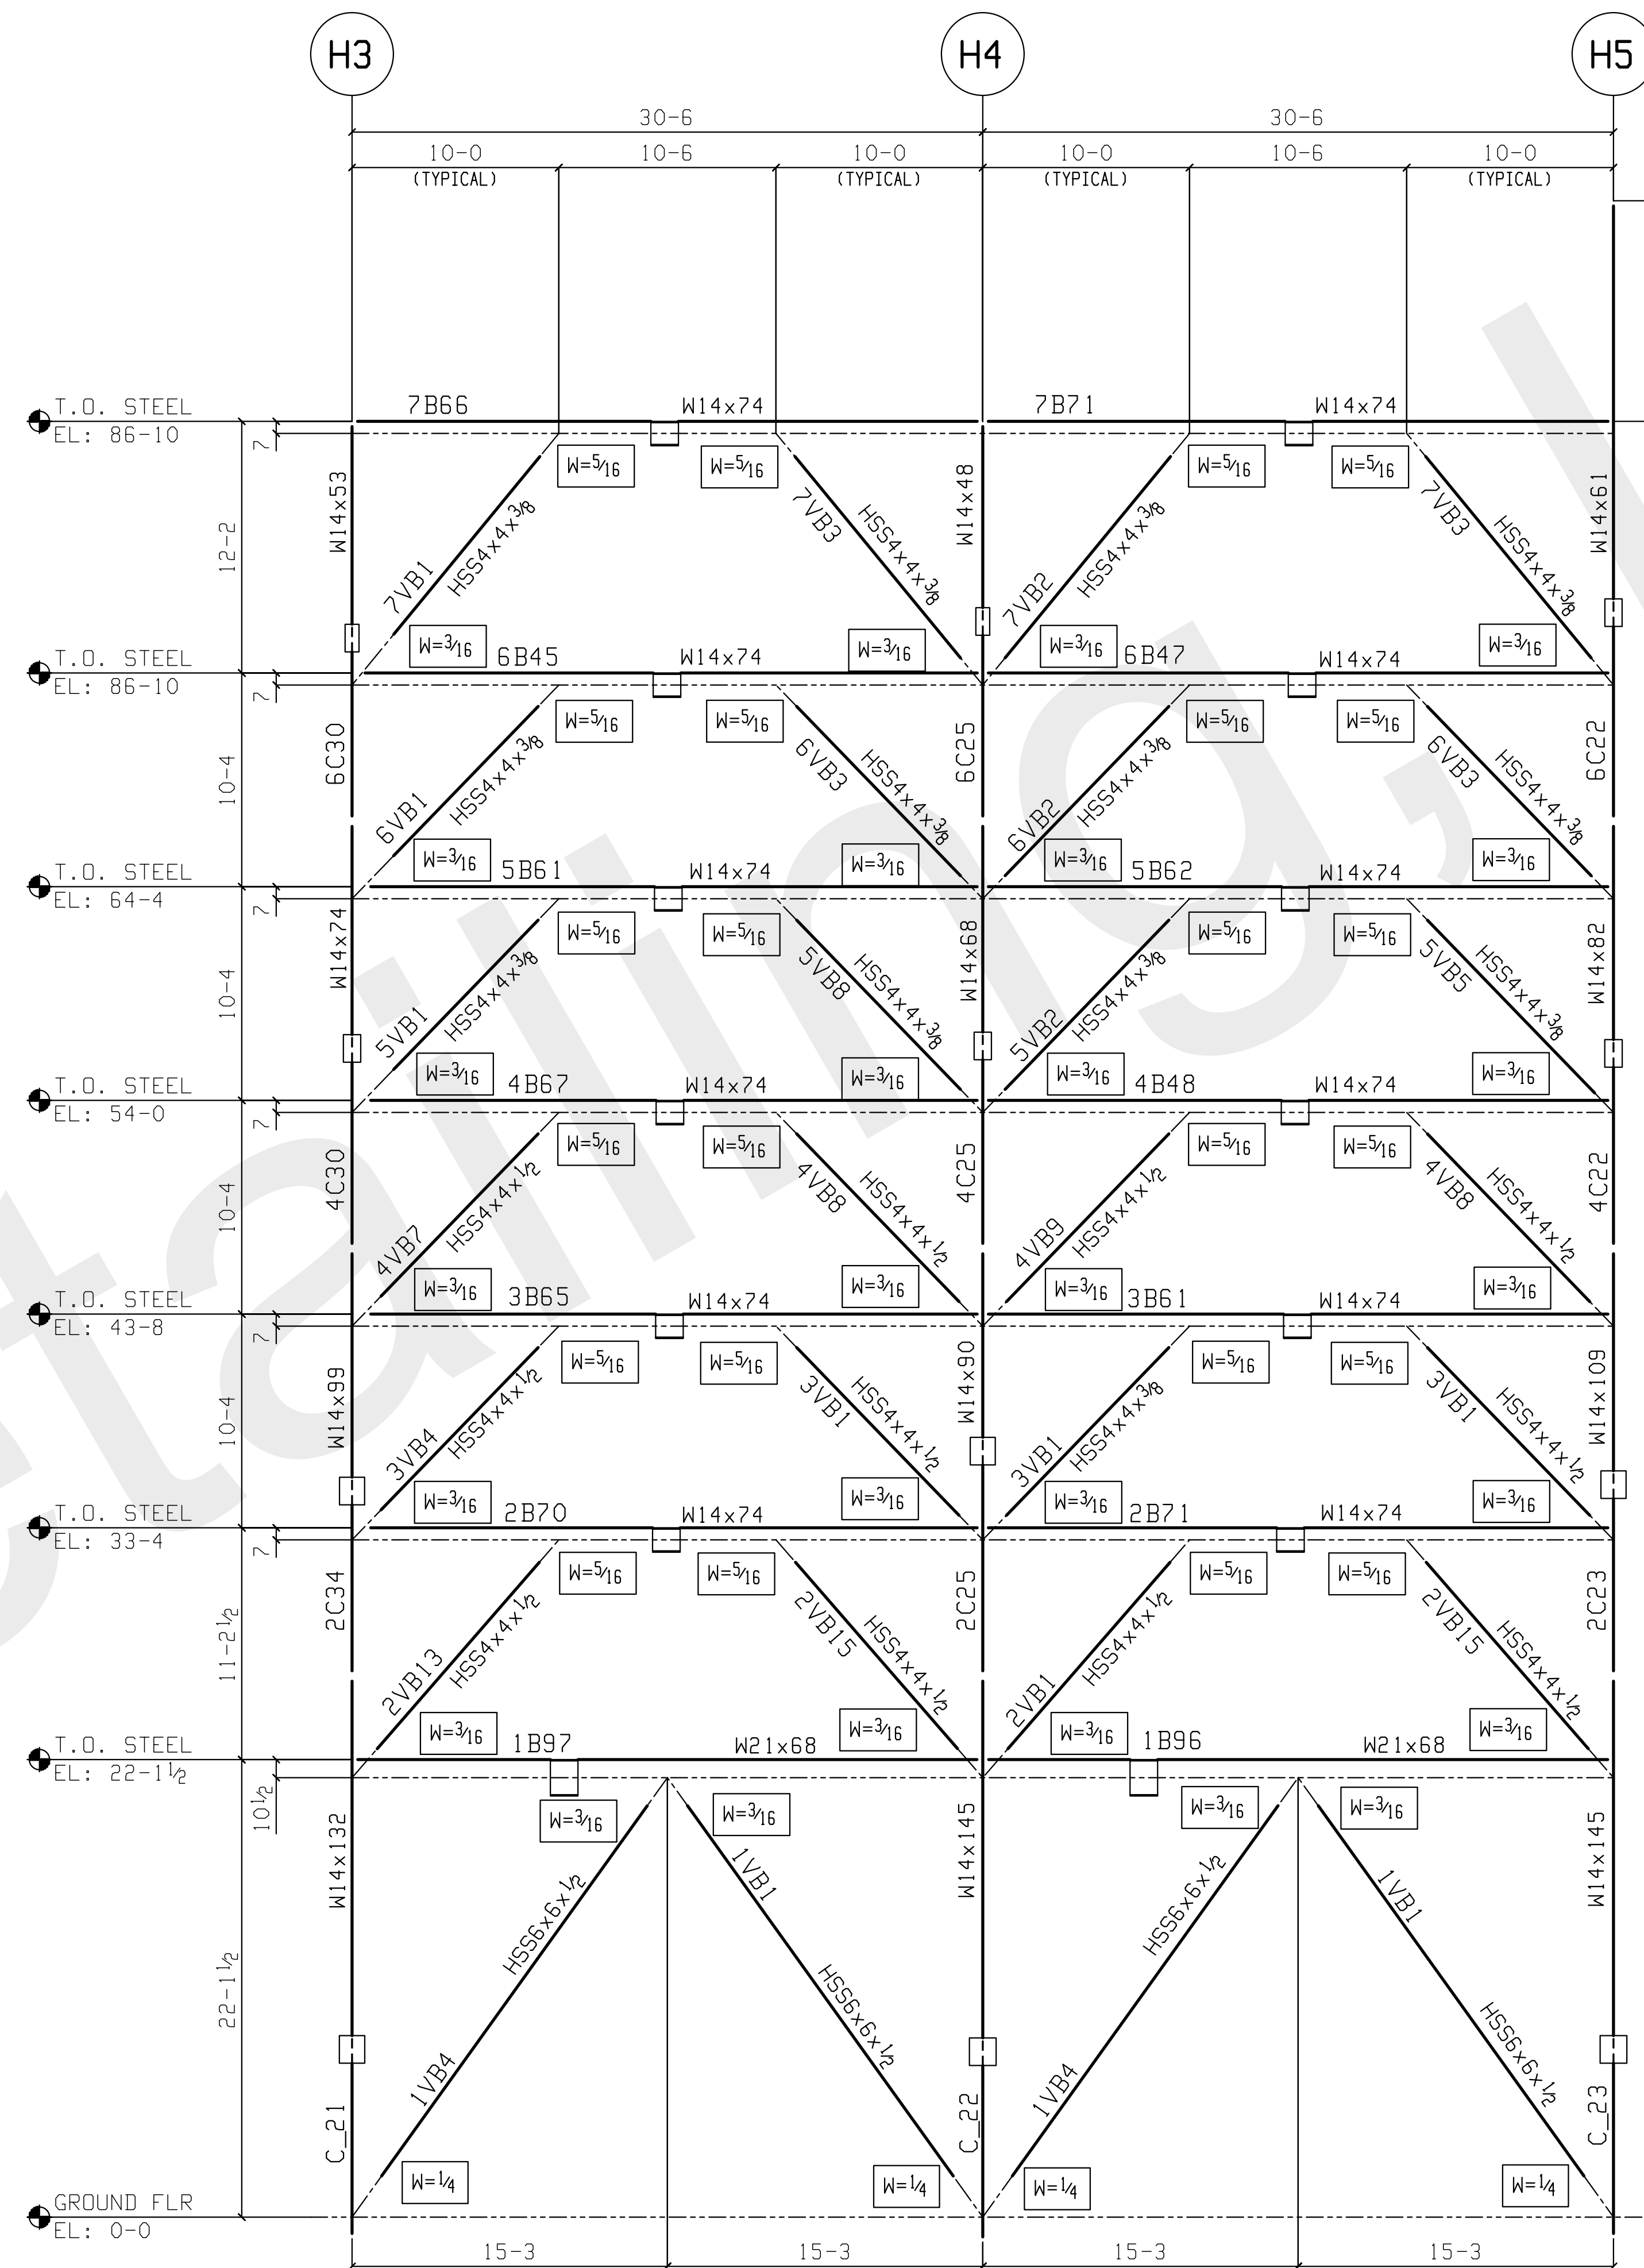

VERTICAL BRACE @ COLUMNLINE "HC"
(LOOKING NORTH)

ALL VERIFIES, REQUEST FOR INFORMATION NOT
RESPONDED TO AND/OR DIMENSIONS NOT FURNISHED
WILL PLACE AFFECTED STEEL ON HOLD.
JEFFORDS STEEL AND ENGINEERING ASSUMES NO
RESPONSIBILITY FOR ERRORS RESULTING FROM
CONFLICTS IN CONTRACT DRAWINGS (ARCHITECTURAL/
STRUCTURAL).

GENERAL NOTES:
CHARGES FOR CORRECTIVE WORK WILL NOT BE HONORED UNLESS
PREVIOUS APPROVAL IS OBTAINED FROM JEFFORDS STEEL AND
ENGINEERING COMPANY.
MEMBERS ARE TO BE ERECTED SO THAT MARKED END IS IN THE
SAME LOCATION AS ON THE ERECTION DRAWING.

DRAWINGS PREPARED BY:
GLOBAL DETAILING, INC.
JOB # 12-396




print record	1	APP	3-12
	1	FIELD	4-12
job no. 600	1	FIELD	5-12
	1	FIELD	5-12
date 3-12	1	FIELD	5-12
	1	FIELD	5-12
drawn by TC	1	FIELD	5-12
	1	FIELD	5-12
checked by -	1	FIELD	5-12
	1	FIELD	5-12

revisions	1	GEN. REVS & ADDED WELD DETAIL
	1	5-7

customer	AKWESASNE MOHAWK HOTEL
	873 STATE HIGHWAY 37

project	AKWESASNE MOHAWK HOTEL
	873 STATE HIGHWAY 37

sheet	E10

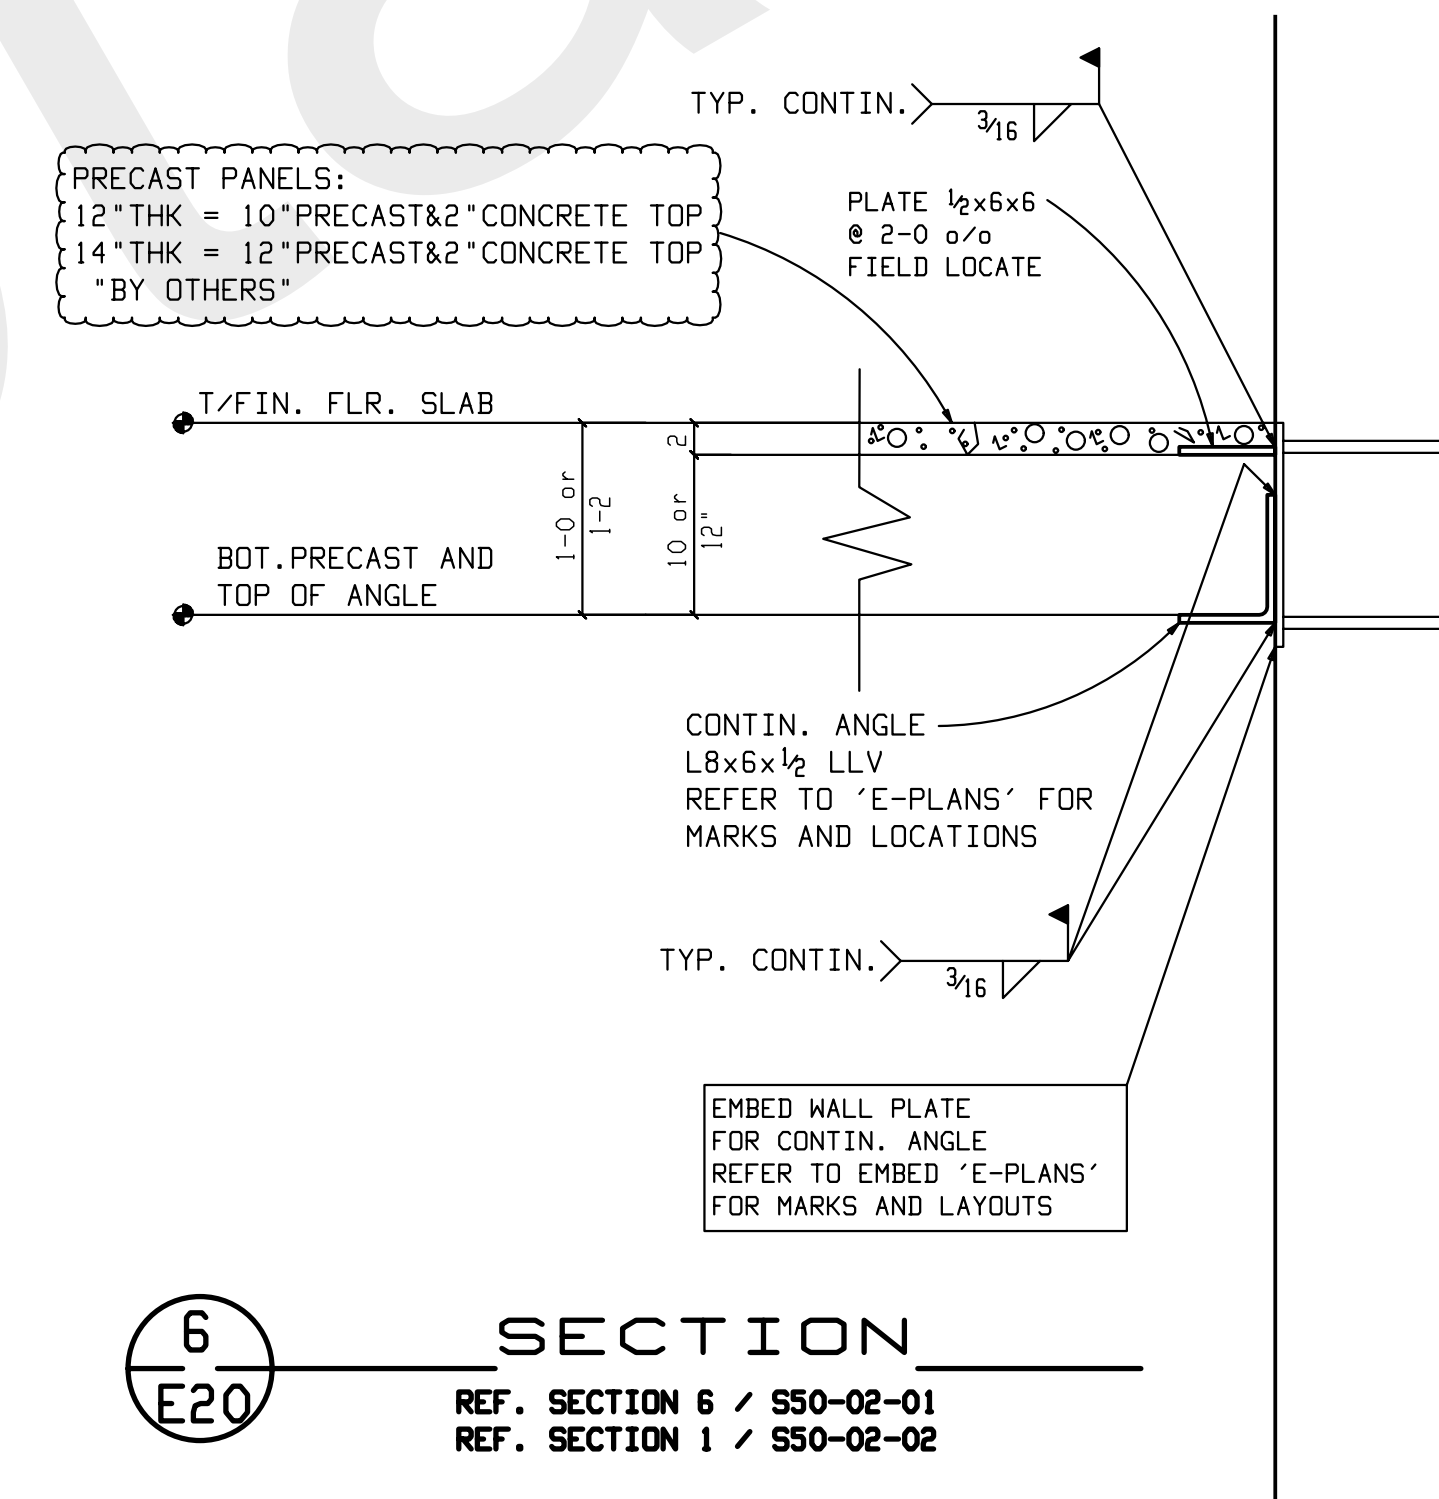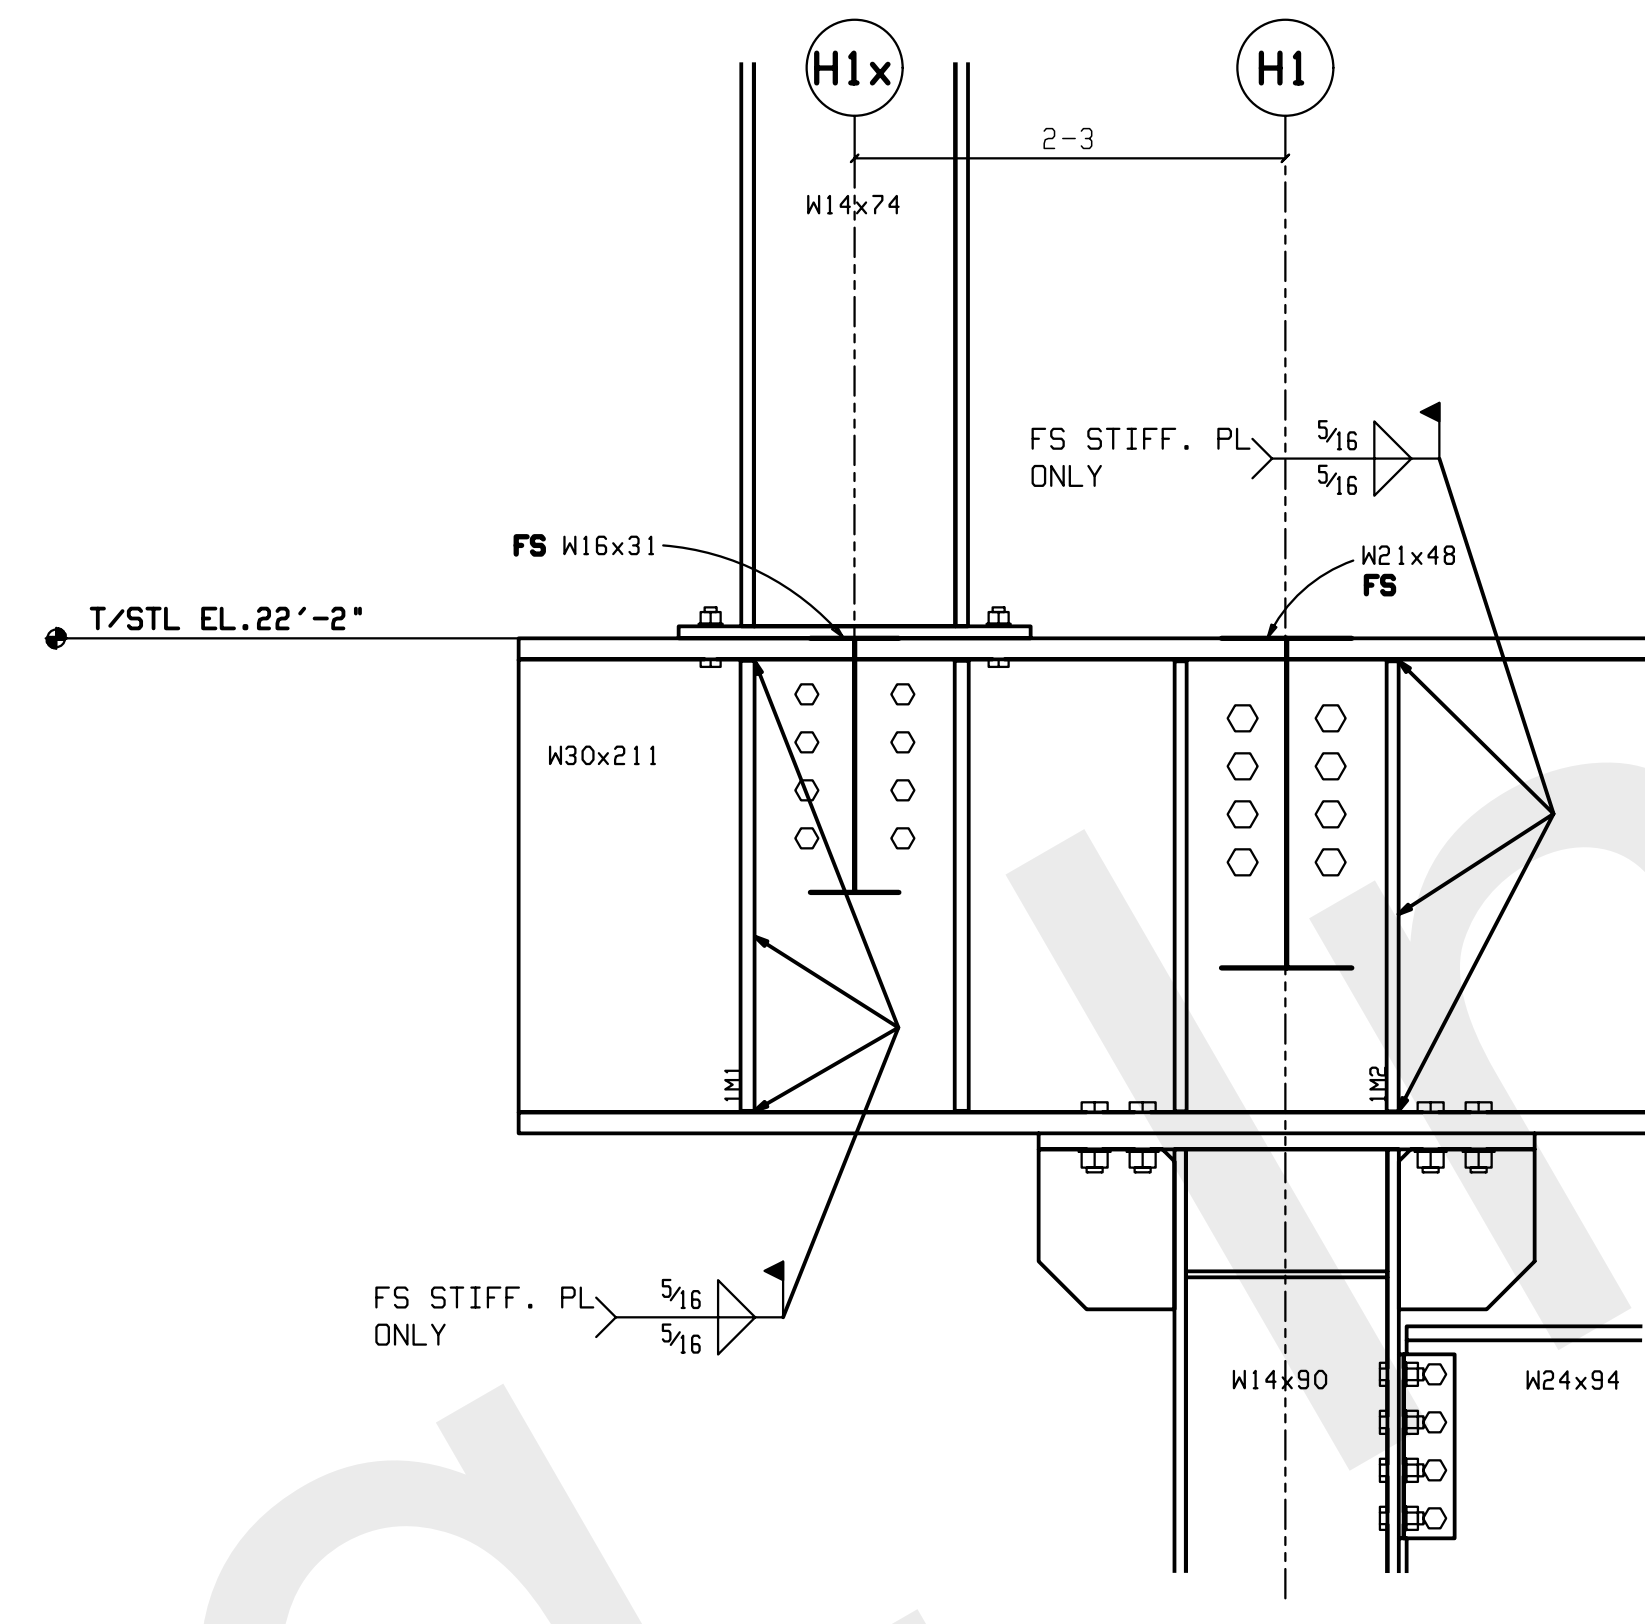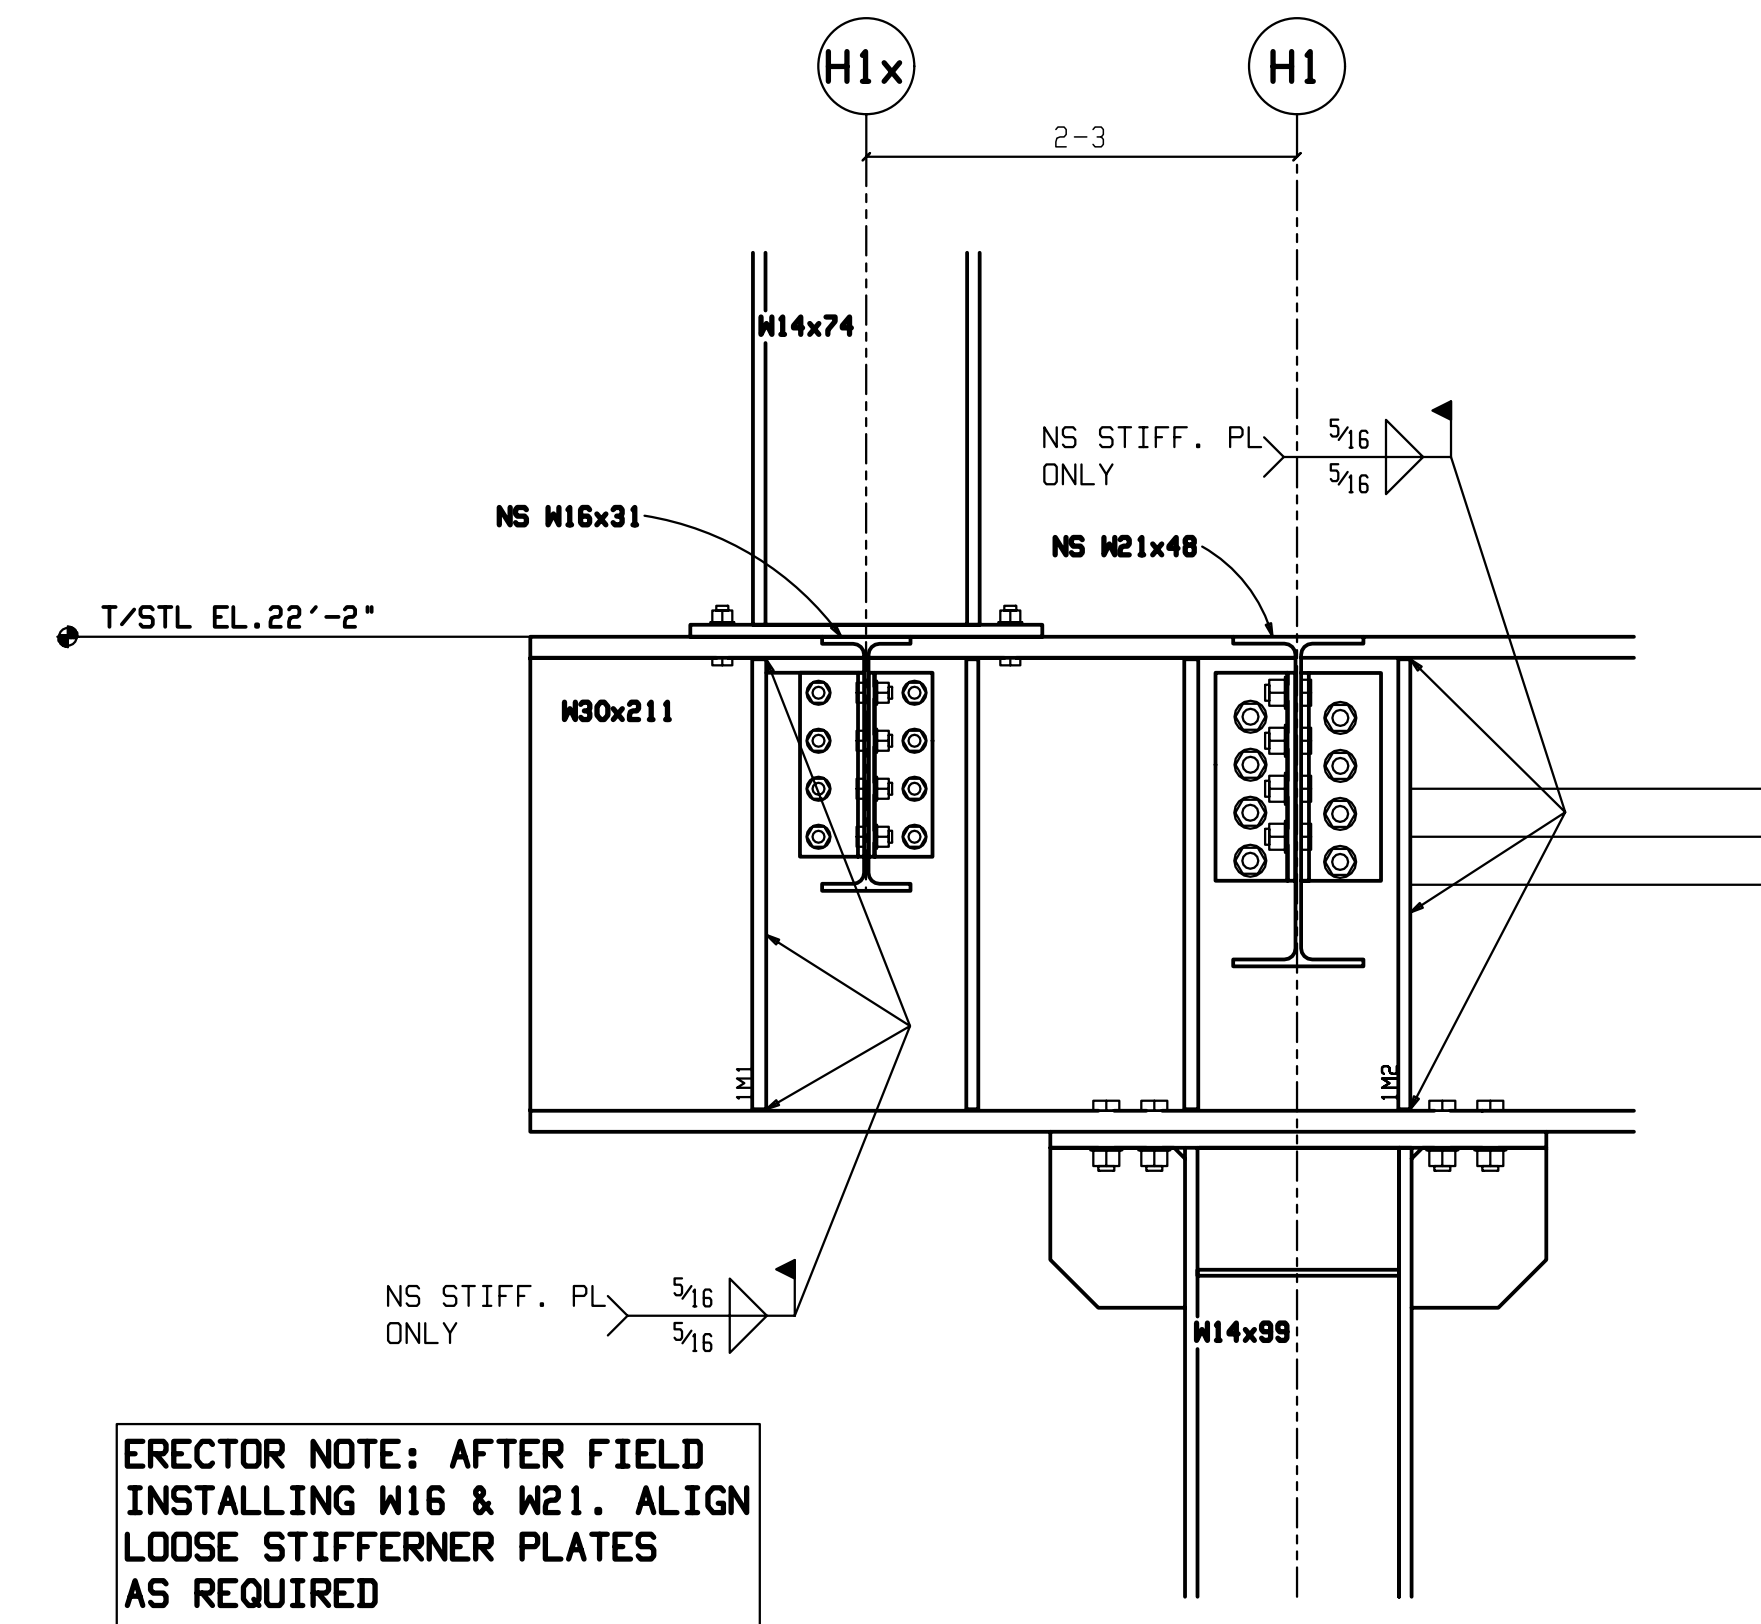

ALL VERIFIES, REQUEST FOR INFORMATION NOT
RESPONDED TO AND/OR DIMENSIONS NOT FURNISHED
WILL PLACE AFFECTED STEEL ON HOLD.

JEFFORDS STEEL AND ENGINEERING ASSUMES NO
RESPONSIBILITY FOR ERRORS RESULTING FROM
CONFLICTS IN CONTRACT DRAWINGS (ARCHITECTURAL/
STRUCTURAL).

GENERAL NOTES:

CHARGES FOR CORRECTIVE WORK WILL NOT BE HONORED UNLESS PREVIOUS APPROVAL IS OBTAINED FROM JEFFORDS STEEL AND ENGINEERING COMPANY.

MEMBERS ARE TO BE ERECTED SO THAT MARKED END IS IN THE SAME LOCATION AS ON THE ERECTION DRAWING.